

STATE ENGINEER
Salem, Oregon

CLAC 00619

Well Record

STATE WELL NO. 1/3-29R
COUNTY Multnomah
APPLICATION NO. GR-3903

Clack

OWNER: J. C. & Ruth A. Lowie


MAILING ADDRESS: Rt. 2, Box 440

LOCATION OF WELL: Owner's No.

CITY AND STATE: Troutdale, Oregon

SE 1/4 SE 1/4 Sec. 29 T. 1 N. R. 3 E., W.M.

Bearing and distance from section or subdivision
corner N 23° 45' W SE corner Sec. 29 550'

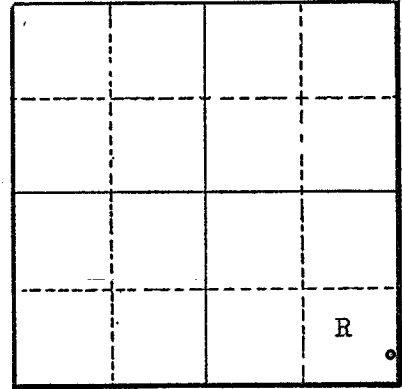

Section 29

Altitude at well 100'

TYPE OF WELL: Drilled Date Constructed Jan. '30

Depth drilled 48' Depth cased 48'

CASING RECORD:

FINISH:

AQUIFERS:

WATER LEVEL:

48'

PUMPING EQUIPMENT: Type Myers Jet H.P. 3/4
Capacity 10 G.P.M.

WELL TESTS:

Drawdown ft. after hours G.P.M.
Drawdown ft. after hours G.P.M.

USE OF WATER Stock & Irrigation Temp. °F., 19

SOURCE OF INFORMATION GR-4003

DRILLER or DIGGER

ADDITIONAL DATA:

Log NA Water Level Measurements Chemical Analysis Aquifer Test

REMARKS: