


STATE ENGINEER
Salem, Oregon

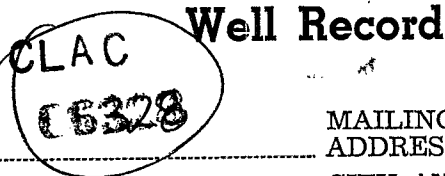

STATE WELL NO. 2/4-28 N
COUNTY CLACKAMAS
APPLICATION NO. GR-2552

OWNER: Paul A. Still


MAILING
ADDRESS: Rt 1 Box 240

LOCATION OF WELL: Owner's No.

CITY AND
STATE: Eagle Creek, Oregon

56 1/4 Sec. 28 T. 2 S. R. 4 E. W.M.

Bearing and distance from section or subdivision
corner 600' N & 480' E from SW cor Sec 28

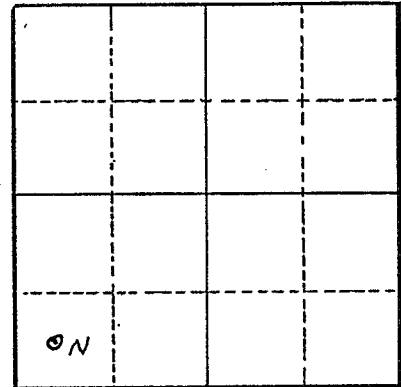

Altitude at well

TYPE OF WELL: Drilled Date Constructed 1952

Depth drilled 150' Depth cased

Section 28

CASING RECORD:

FINISH:

AQUIFERS:

WATER LEVEL:

PUMPING EQUIPMENT: Type H.P.
Capacity G.P.M.

WELL TESTS:

Drawdown ft. after hours 20 G.P.M.
Drawdown ft. after hours G.P.M.

USE OF WATER Irrigation Temp. °F. 19
SOURCE OF INFORMATION GR-3902

DRILLER or DIGGER

ADDITIONAL DATA:

Log NA Water Level Measurements Chemical Analysis Aquifer Test

REMARKS: