

STATE ENGINEER  
Salem, Oregon

**CLAC Well Record**  
**6386**

STATE WELL NO. 2/4-29H  
COUNTY Clackamas  
APPLICATION NO. GR-3892

OWNER: J. E. Jarvis


MAILING ADDRESS: Route 1, Box 233

LOCATION OF WELL: Owner's No. \_\_\_\_\_

CITY AND STATE: Eagle Creek, Oregon

SE 1/4 NE 1/4 Sec. 29 T. 2 N. S., R. 4 W., W.M.

Bearing and distance from section or subdivision  
corner 1000' W. 350' N. from E 1/4 cor. Sec. 29

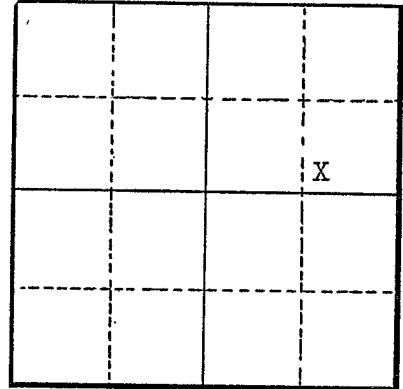

Section 29

Altitude at well \_\_\_\_\_

TYPE OF WELL: Drilled Date Constructed 8/1/55

Depth drilled 200 ft. Depth cased 150 ft.

CASING RECORD:

8 inch casing set to 150 feet

FINISH:

4 cuts per 10" from 105 to 148

AQUIFERS:

WATER LEVEL:

PUMPING EQUIPMENT: Type Jacuzzi turbine H.P. 10  
Capacity 100 G.P.M.

WELL TESTS:

Drawdown 80 ft. after \_\_\_\_\_ hours 100 G.P.M.  
Drawdown \_\_\_\_\_ ft. after \_\_\_\_\_ hours \_\_\_\_\_ G.P.M.

USE OF WATER Irrigation Temp. \_\_\_\_\_ °F., 19

SOURCE OF INFORMATION Well Registration Statement Cert. # GR-3536

DRILLER or DIGGER \_\_\_\_\_

ADDITIONAL DATA:

Log  Water Level Measurements \_\_\_\_\_ Chemical Analysis \_\_\_\_\_ Aquifer Test \_\_\_\_\_

REMARKS:

Log	Thickness	Depth to Bottom
Top soil	1	2
Clay	2	50
Cemented gravel	50	100
Heavy sand	100	105
Sand & gravel with water	105	148
Sandstone	150	180
Blue clay	180	200

Well refilled to 175