


STATE ENGINEER  
Salem, Oregon

OBSERVATION WELL

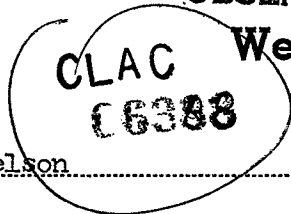

Well Record

STATE WELL NO. 2/4-29J(1)  
COUNTY Clackamas  
APPLICATION NO. GR-1793

GR- 1735

OWNER: Virgil W. Nelson


MAILING ADDRESS: Rt. 1, Box 237

LOCATION OF WELL: Owner's No.

CITY AND STATE: Eagle Creek, Oregon

NE 1/4 SE 1/4 Sec. 29 T. 2 S., R. 4 E., W.M.

Bearing and distance from section or subdivision corner N. 18° W. 1965' from SE cor Sec. 29

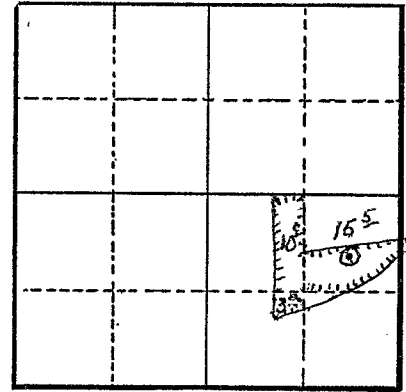

Section 29

Altitude at well 710'

TYPE OF WELL: Drilled Date Constructed 1952

Depth drilled 176' Depth cased 176'

CASING RECORD:

6"

FINISH:

Mills knife perforations: 3/16" x 1 1/2" (4/ft.) from 95 to 110 ft.  
" " " " " " " " " 129 to 149 ft.

AQUIFERS:

WATER LEVEL:

67'

PUMPING EQUIPMENT: Type Jacuzzi turbine H.P. 7 1/2  
Capacity 100 G.P.M.

WELL TESTS:

Drawdown 58 ft. after hours 70 G.P.M.  
Drawdown 38 ft. after Jan. 6, '53 hours 60 G.P.M.

USE OF WATER Irrigation Temp. °F., 19

SOURCE OF INFORMATION GR Record

DRILLER or DIGGER

ADDITIONAL DATA:

Log X Water Level Measurements Chemical Analysis Aquifer Test

REMARKS: SEE WATER WELL REPORT-NEXT PAGE

Irrigation of 30.5 acres.