


NOTICE TO WATER WELL CONTRACTOR

The original and first copy of this report are to be filed with the

STATE ENGINEER, SALEM, OREGON 97310

within 30 days from the date of well completion.

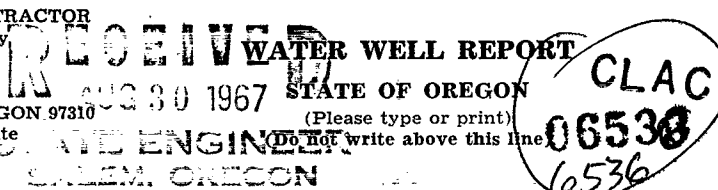

WATER WELL REPORT

(Please type or print)

(Do not write above this line)

State Well No. 2/4-32

State Permit No.

(1) OWNER:

Name Ms. E. G. Schwanburg
Address RT-1 Eagle Creek, Oregon Box 200

(2) TYPE OF WORK (check):

New Well ☒ Deepening ☐ Reconditioning ☐ Abandon ☐

If abandonment, describe material and procedure in Item 12.

(3) TYPE OF WELL:

Rotary ☐ Driven ☐
Cable ☒ Jetted ☐
Dug ☐ Bored ☐

(4) PROPOSED USE (check):

Domestic ☒ Industrial ☐ Municipal ☐
Irrigation ☐ Test Well ☐ Other ☐

(5) CASING INSTALLED:

Threaded ☐ Welded ☒

6" Diam. from 0 ft. to 31.5 ft. Gage 250
5 1/2" Diam. from 26 ft. to 110 ft. Gage 18
" Diam. from ft. to ft. Gage

(6) PERFORATIONS:

Perforated? ☐ Yes ☒ No

Type of perforator used Cutting Torch
Size of perforations 4" in. by 1/8" in.
80 perforations from 90 ft. to 110 ft.
perforations from ft. to ft.
perforations from ft. to ft.
perforations from ft. to ft.
perforations from ft. to ft.

(7) SCREENS:

Well screen installed? ☐ Yes ☒ No

Manufacturer's Name
Type Model No.
Diam. Slot size Set from ft. to ft.
Diam. Slot size Set from ft. to ft.

(8) WATER LEVEL: Completed well.

Static level 39 ft. below land surface Date 8/14/67
Artesian pressure lbs. per square inch Date

(9) WELL TESTS:

Drawdown is amount water level is lowered below static level

Was a pump test made? ☐ Yes ☐ No If yes, by whom?

Yield: gal./min. with ft. drawdown after hrs.
" " " "

Bailer test 4 gal./min. with 61 ft. drawdown after 1 hrs.

Artesian flow g.p.m. Date

Temperature of water Was a chemical analysis made? ☐ Yes ☐ No

(10) CONSTRUCTION:

Well seal—Material used Bentonite & Cement
Depth of seal 22' ft.
Diameter of well bore to bottom of seal 16 in.
Were any loose strata cemented off? ☐ Yes ☐ No Depth
Was a drive shoe used? ☒ Yes ☐ No
Did any strata contain unusable water? ☐ Yes ☐ No
Type of water? depth of strata
Method of sealing strata off
Was well gravel packed? ☐ Yes ☐ No Size of gravel:
Gravel placed from ft. to ft.

(11) LOCATION OF WELL:

County Clatsop Driller's well number
1/4 NE 1/4 Section 32 T. 2S R. 4E W.M.
Bearing and distance from section or subdivision corner

(12) WELL LOG:

Diameter of well below casing 6

Depth drilled 110 ft. Depth of completed well 110 ft.

Formation: Describe color, texture, grain size and structure of materials; and show thickness and nature of each stratum and aquifer penetrated, with at least one entry for each change of formation. Report each change in position of Static Water Level as drilling proceeds. Note drilling rates.

MATERIAL	From	To	SWL
Brown loam & gravel	0	3	
" Clay "	3	22	
Cemented gravel	22	30	
Brown clay	30	39	
grey clay	39	93	
fine sand, grey clay	93	95	
grey clay	95	110	

Work started 8/8 1967 Completed 8/17 1967

Date well drilling machine moved off of well " 19

Drilling Machine Operator's Certification:

This well was constructed under my direct supervision. Materials used and information reported above are true to my best knowledge and belief.

[Signed] William Nelson Date 8/23, 1967
(Drilling Machine Operator)

Drilling Machine Operator's License No. 506

Water Well Contractor's Certification:

This well was drilled under my jurisdiction and this report is true to the best of my knowledge and belief.

NAME ANDY M. JANSEN WELL DRILLING
(Person, firm or corporation) (Type or print)

Address ROUTE 1, BOX 275, ESTACADA, ORE. 97023

[Signed] Andy M. Jansen
(Water Well Contractor)

Contractor's License No. 42 Date 8/23, 1967