

STATE ENGINEER
Salem, Oregon

6724 Well Record
CLAC

STATE WELL NO. 2/5-7A
COUNTY Clackamas
APPLICATION NO. GR-3463

OWNER: David C. Klingler

MAILING ADDRESS: Route 1, Box 544


LOCATION OF WELL: Owner's No.

CITY AND STATE: Sandy, Oregon

NE 1/4 NE 1/4 Sec. 7 T. 2 N. 5 E. W.M.

Bearing and distance from section or subdivision

corner S 5° 30' W., 183'

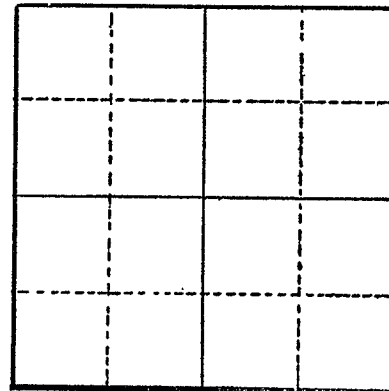

Section

Altitude at well

TYPE OF WELL: drilled Date Constructed 1946

Depth drilled 63' Depth cased 63'

CASING RECORD:

6"

FINISH:

AQUIFERS:

WATER LEVEL:

14'

PUMPING EQUIPMENT: Type Homart Multistage H.P. 1
Capacity 12 G.P.M.

WELL TESTS:

Drawdown ft. after hours G.P.M.

Drawdown ft. after hours G.P.M.

USE OF WATER Irrigation Temp. °F. 19

SOURCE OF INFORMATION GR-3204

DRILLER or DIGGER Kaniman (formerly of Boring)

ADDITIONAL DATA:

Log Water Level Measurements Chemical Analysis Aquifer Test

REMARKS: