

STATE OF OREGON

WATER SUPPLY WELL REPORT

(as required by ORS 537.765 & OAR 690-205-0210)

06-30-2011

WELL LABEL # L 92637

START CARD # 1013910

(1) LAND OWNER

Owner Well I.D. _____

First Name DALE Last Name EDMUNDS

Company _____

Address 17693 S RAMSBY RD

City MOLALLA State OR Zip 97038

(2) TYPE OF WORK

☒ New Well ☐ Deepening ☐ Conversion

☐ Alteration (repair/recondition) ☐ Abandonment

(3) DRILL METHOD

☒ Rotary Air ☐ Rotary Mud ☐ Cable ☐ Auger ☐ Cable Mud

☐ Reverse Rotary ☐ Other _____

(4) PROPOSED USE

☒ Domestic ☐ Irrigation ☐ Community

☐ Industrial/ Commercial ☐ Livestock ☐ Dewatering

☐ Thermal ☐ Injection ☐ Other _____

(5) BORE HOLE CONSTRUCTION

Special Standard ☐ (Attach copy)

Depth of Completed Well 132.00 ft.

BORE HOLE			SEAL			sacks/	
Dia	From	To	Material	From	To	Amt	lbs
10	0	51	Bentonite Chips	0	51	21	S
6	51	132					

How was seal placed: Method ☐ A ☐ B ☐ C ☐ D ☐ E

☒ Other poured and probed

Backfill placed from _____ ft. to _____ ft. Material _____

Filter pack from _____ ft. to _____ ft. Material _____ Size _____

Explosives used: ☐ Yes Type _____ Amount _____

(6) CASING/LINER

Casing	Liner	Dia	+	From	To	Gauge	Stl	Plstc	Wld	Thrd
☒	☐	6	☒	3	51	.250	☒	☐	☒	☐
☐	☒	4	☐	3	132	160	☐	☒	☐	☐
☐	☐		☐				☐	☐	☐	☐
☐	☐		☐				☐	☐	☐	☐
☐	☐		☐				☐	☐	☐	☐

Shoe ☒ Inside ☒ Outside ☐ Other Location of shoe(s) 51.6

Temp casing ☐ Yes Dia _____ From _____ To _____

(7) PERFORATIONS/SCREENS

Perforations Method skill saw

Screens Type _____ Material _____

Perf/S	Casing/ Screen	Liner	Dia	From	To	Scrn/slot width	Slot length	# of slots	Tele/ pipe size
Perf	Liner	4	72	112	.25	4	80		

(8) WELL TESTS: Minimum testing time is 1 hour

☐ Pump ☐ Bailer ☒ Air ☐ Flowing Artesian

Yield gal/min	Drawdown	Drill stem/Pump depth	Duration (hr)
23		132	1

Temperature 55 °F Lab analysis ☐ Yes By _____

Water quality concerns? ☐ Yes (describe below)

From	To	Description	Amount	Units

(9) LOCATION OF WELL (legal description)

County Clackamas Twp 5.00 S N/S Range 2.00 E E/W WM

Sec 25 SW 1/4 of the NE 1/4 Tax Lot 00600

Tax Map Number _____ Lot _____

Lat _____ " or _____ DMS or DD

Long _____ " or _____ DMS or DD

☒ Street address of well ☐ Nearest address

17693 S RAMSBY RD MOLALLA OREGON 97038

(10) STATIC WATER LEVEL

Date SWL(psi) + SWL(ft)

Existing Well / Predeepening			
Completed Well	06-29-2011		38

Flowing Artesian? ☐ Dry Hole? ☐

WATER BEARING ZONES Depth water was first found 86

SWL Date	From	To	Est Flow	SWL(psi)	+ SWL(ft)
06-29-2011	86	118	23		38

(11) WELL LOG

Ground Elevation _____

Material	From	To
brown clay	0	1
boulders and brown clay	1	7
brown clay	7	16
blue claystone	16	28
gray claystone	28	48
brown claystone	48	51
gray claystone	51	86
tan claystone	86	118
brown claystone	118	132

Date Started 06-27-2011 Completed 06-29-2011

(unbonded) Water Well Constructor Certification

I certify that the work I performed on the construction, deepening, alteration, or abandonment of this well is in compliance with Oregon water supply well construction standards. Materials used and information reported above are true to the best of my knowledge and belief.

License Number _____ Date _____

Electronically Filed

Signed _____

(bonded) Water Well Constructor Certification

I accept responsibility for the construction, deepening, alteration, or abandonment work performed on this well during the construction dates reported above. All work performed during this time is in compliance with Oregon water supply well construction standards. This report is true to the best of my knowledge and belief.

License Number 728 Date 06-30-2011

Electronically Filed

Signed DANIEL P MERRILL (E-filed)

Contact Info (optional) Merrill Water Systems 503 734 7400

CLAC 67959




First American Title Insurance Company of Oregon

An assumed business name of TITLE INSURANCE COMPANY OF OREGON

*This map is provided as a convenience in locating property
First American Title Insurance Company assumes no liability for any variations as may be disclosed by an actual survey*

Reference Parcel Number 52E25 00600

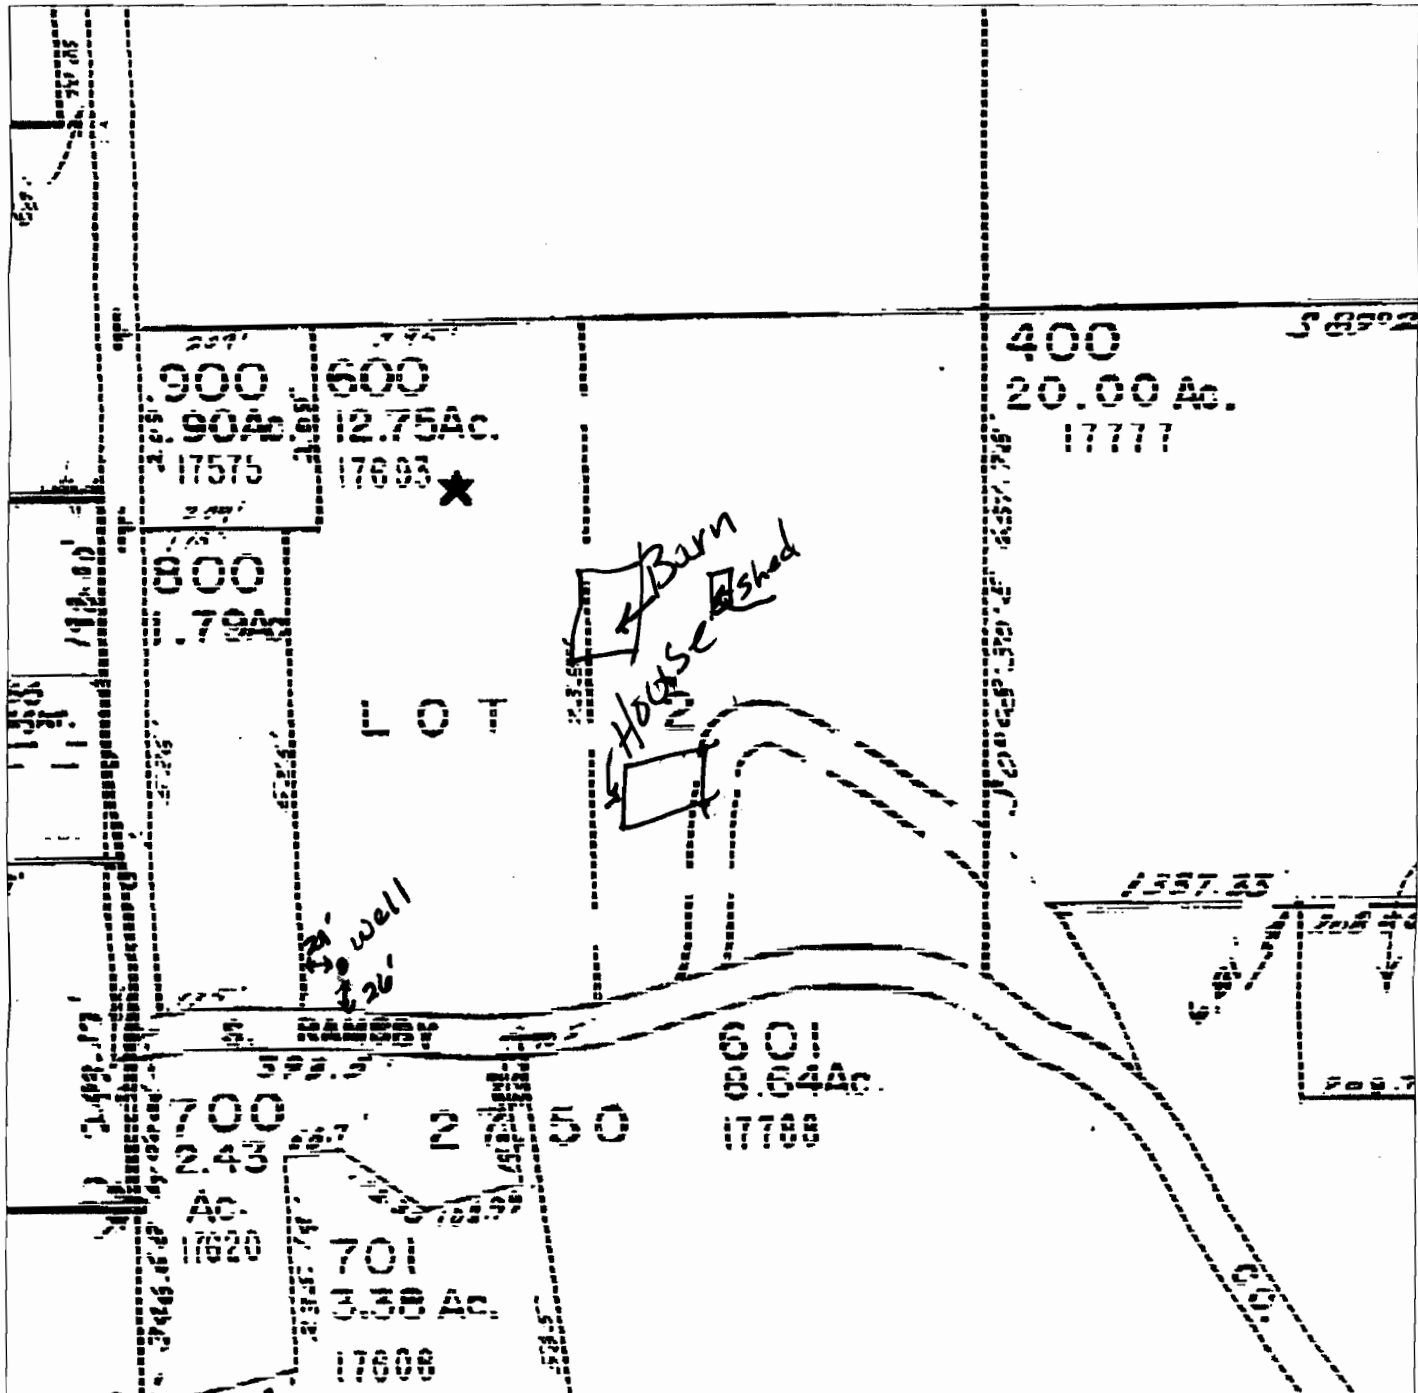

Start Card # 1013910
well Tag 92637

RECEIVED

AUG 02 2011

WATER RESOURCES DEPT
SALEM, OREGON