

STATE ENGINEER
Salem, Oregon

Well Record

STATE WELL NO. 2/5-19B
COUNTY CLACKAMAS
APPLICATION NO. GR-2463

OWNER: Delbert W. Gillum


MAILING ADDRESS: Rt. 2, Box 33

LOCATION OF WELL: Owner's No. _____

CITY AND STATE: Sandy, Oregon

NW 1/4 NE 1/4 Sec. 19 T. 2 S., R. 5 E., W.M.

Bearing and distance from section or subdivision corner 2100' W. and 750' S.

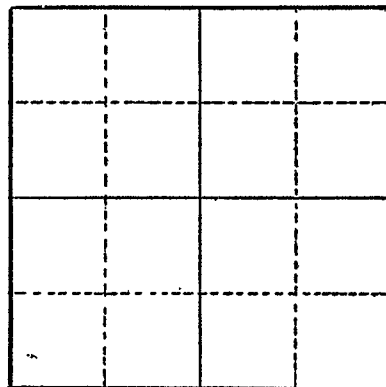

Altitude at well _____

TYPE OF WELL: Drilled Date Constructed 1951

Depth drilled 320 Depth cased 245

Section _____

CASING RECORD:

8-inch

FINISH:

Perforated 8" casing from 100 to 180
Size of perforations unknown

AQUIFERS:

Clay, gravel, shale and sand

WATER LEVEL:

120-feet

PUMPING EQUIPMENT: Type Pacific Beverford H.P. 10
Capacity _____ G.P.M.

WELL TESTS:

Drawdown _____ ft. after _____ hours Pumping 60 G.P.M.

Drawdown _____ ft. after _____ hours _____ G.P.M.

USE OF WATER Irrigation Temp. _____ °F. _____, 19 _____

SOURCE OF INFORMATION GR-2333

DRILLER or DIGGER _____

ADDITIONAL DATA:

Log X Water Level Measurements _____ Chemical Analysis _____ Aquifer Test _____

REMARKS:

STATE ENGINEER
Salem, Oregon

State Well No. 2/5-19B
County Clackamas
Application No. GR-2463

Well Log

Owner: Delbert W. Gillum Owner's No.

Driller: Date Drilled 1951

CHARACTER OF MATERIAL	(Feet below land surface)		Thickness (feet)
	From	To	
Clay	0	65	65
Conglomerate, approx. 2 gallons water per min.	65	95	30
Cement gravel	95	113	18
Brown clay	113	120	7
Conglomerate, bailing 7 gallons per minute	120	140	20
Cement gravel	140	160	20
Coarse water sand & gravel 30 gallons per min.	160	162	2
Cement gravel	162	187	25
Brown clay water shut off	187	195	8
Cement gravel	195	203	8
Fine sand, no water	203	205	2
Cement gravel	205	225	20
Caving in - drove pipe	225	230	5
Cement gravel	230	263	33
Brown and yellow clay	263	275	12
Seepage approx. 1 gallon	275	280	5
Brown shale	280	310	30
Black sand	310	318	8
Clay	318	320	2