

STATE ENGINEER
Salem, Oregon

CLAC 7258 Well Record

STATE WELL NO. 2/5-32c
COUNTY Mult.
APPLICATION NO. GR 2265
GR 2162

OWNER: Philly M. Cousins


MAILING ADDRESS: Rt 2, Box 126

LOCATION OF WELL: Owner's No.

CITY AND STATE: Sandy, Oregon

NE 1/4 NW 1/4 Sec. 32 T. 2 N. S. R. 5 W. W.M.

Bearing and distance from section or subdivision corner 80' S & 1340' E. from the NW corner section 32

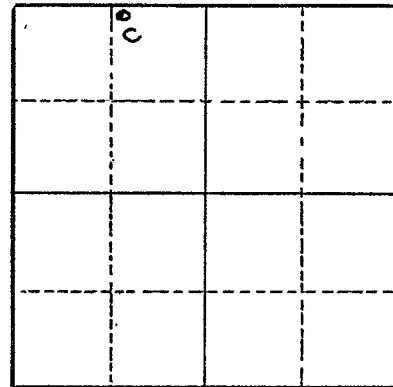

Section 32

Altitude at well

TYPE OF WELL: Drilled Date Constructed Prior 1947

Depth drilled 75 Depth cased ?

CASING RECORD:

6-inch

FINISH:

Unknown

AQUIFERS:

Unknown

WATER LEVEL:

40' below land surface

PUMPING EQUIPMENT: Type H.P.
Capacity G.P.M.

WELL TESTS:

Drawdown to bottom ft. after hours Pumping 35 G.P.M.

Drawdown ft. after hours G.P.M.

USE OF WATER Irrigation 11 1/2 ac Temp. °F., 19

SOURCE OF INFORMATION GR 2265

DRILLER or DIGGER Not Known

ADDITIONAL DATA:

Log N.S. Water Level Measurements Chemical Analysis Aquifer Test

REMARKS: