

STATE ENGINEER  
Salem, Oregon

CLAC 00753

See Application G-1209 for loc. desc.  
Well Record

G-3795 STATE WELL NO. 1/3-33(1)  
COUNTY Clackamas  
APPLICATION NO. GR-174

OWNER: O. D. Menser


MAILING ADDRESS: Route 2, Box 797

LOCATION OF WELL: Owner's No. #1

CITY AND STATE: Boring, Oregon

SW 1/4 SE 1/4 Sec. 33 T. 1 N. S., R. 3 W., W.M.

Bearing and distance from section or subdivision corner N. 50° W 2270' from SE corner Sec. 33.

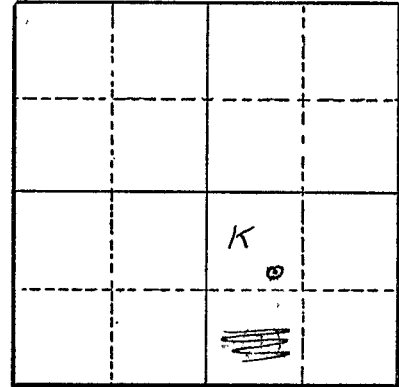

Section 33

Altitude at well 600' Interpolated

TYPE OF WELL: Drilled Date Constructed April 1953

Depth drilled 305' Depth cased 305'

CASING RECORD:

8-inch casing set from 0-245 feet  
6-inch casing set from 245-300 feet

FINISH:

4 - 1/2" x 1" perforation at 3 levels (182'  
also bottom 10' of casing (210'  
(230')

AQUIFERS:

Gravels - 176 to 300'

WATER LEVEL:

150' below land surface May 1953

PUMPING EQUIPMENT: Type turbine H.P. 20  
Capacity 200 G.P.M.

WELL TESTS:

Drawdown 27 ft. after hours Pumping 275 G.P.M.  
Drawdown ft. after hours G.P.M.

USE OF WATER Irrigation 52.13 acres Temp. °F. 19

SOURCE OF INFORMATION Registration Statement GR-174

DRILLER or DIGGER

ADDITIONAL DATA:

Log Yes Water Level Measurements Chemical Analysis Aquifer Test

REMARKS:

