
WATER SUPPLY WELL REPORT (as required by ORS 537.765 & OAR 690-205-0210)  (1) LAND OWNER    Owner Well I.D.   DELL Z R	DMS or DD DMS or DD s si) + SWL(ft) c?
(a) LAND OWNER Owner Well I.D. WELL Z.R First Name Last Name Last Name Company City of Milloankie Address 10722 SE MAIN ST City Milloankie State OREGONZip 97222  (2) TYPE OF WORK New Well Deepening Conversion Alteration (complete 2a & 10) Abandonment(complete 5a) Cai) PRE-ALTERATION Dia + from To Gauge Stl Piste Wid Thrd Casing: Material From To Amt sacks/lbs Scal: Material From To Amt sacks/lbs Rotary Air Rotary Mud Cable Auger Cable Mud Reverse Rotary Other  (4) PROPOSED USE Domestic Irrigation Community Industrial/ Commercicial Livestock Dewatering Thermal Injection Other  (5) BORE HOLE CONSTRUCTION Depth of Completed Well 392 n. BORE HOLE SEAL  OWNER  OWNER  OWNER  County CLACKAMAS Twp 1 N/S Range County CLACKAMA	DMS or DD DMS or DD DMS or DD  s  i) + SWL(n)

20" 0 85 CEMENT GROWN 85" - 92 SACKS 16" 85" 395" Calculated 68	
Constant Gra	
Calculated (11) WELL LOG Ground Elevation	
How was seal placed: Method A B C D E Material Fro	om To
XOINET TRIMMIED FROM BTM to SURFACE W/ AUMP SAND W/ SILT & GRAVEL C	73
Backfill placed from ft. to 11. Material CLAY	
Time bere tion To the transferrer CA(OD one (M) C	00 230
Explosives used: Yes Type Amount 6/9 SAND W/SILT Z	30 242 42 270
	70 310
Proposed Amount Pounds Pounds Pounds Ogavet W/ Sand, Sur And CLAY 3	10 370
CASING/LINER Casing Liner Dia + From To Gauge Stl Plate Wid Third	70 395
© 16 ± 3 220 1375 © 0 X □ RECEIVED	<del></del>
R-AI-I-R-AI-I-	
Shoe Inside Outside Other Location of shoe(s)	
Temp casing X Yes Dia 20" From 85 To OWRD	
1000	
PERFORATIONS/SCREENS Perforations Method	
Screens Type JOHNSON WIFE WENTATION SS 304 Date Started 4-Z3-19 Completed 1	0-8-19
Perf/S Casing/ Screen Scrn/slot Slot # of Tele/	
creen Liner Dia From To width length slots pipe size (unbanded) Water Well Constructor Certification    NZ' 392 389 1000 3'   P1PE   1 certify that the work 1 performed on the construction, a	land a few attacks and a
S 12' 392 389 1000 3' PIPE I certify that the work I performed on the construction, a shandonment of this well is in compliance with Ore	
S   Z' 375 370 .050 5'   PiPE   construction standards. Materials used and information re	
S 12' 310 302 050 8' Fife the best of my knowledge and belief.	
WELL TESTS: Minimum testing time is 1 hour	<del></del>

Pa. ZoFZ

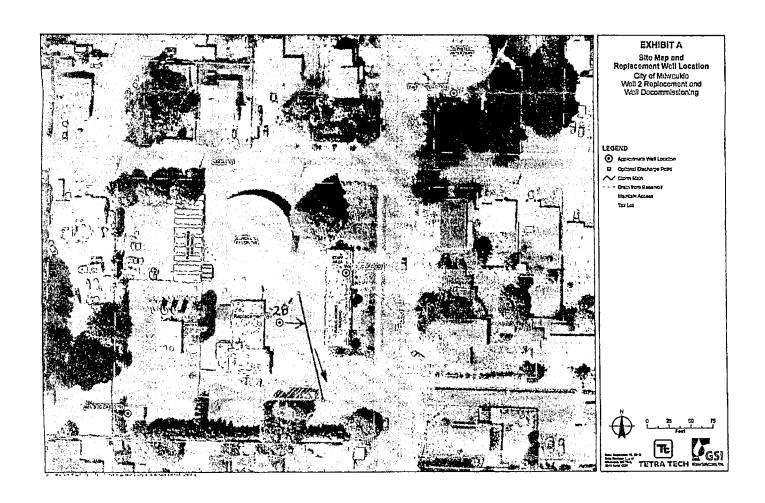

RECEIVED

OCT 1 6 2019

OWRD