

STATE OF OREGON WATER SUPPLY WELL REPORT

WESTERBERG DRILLING INC PO BOX 1228

WELL I.D. LABEL# L 151651 START CARD # 1070460 ORIGINAL LOG #

(as required by ORS 537.545 & 537.765 and OAR 690-205-0210)

WOLALLA, OR 97038

(1) LAND OWNER

Owner Well I.D. First Name Last Name Company Iseli Nursery Address 30590 SE Kelso Rd City Boring State OR Zip 97009

(2) TYPE OF WORK

New Well Deepening Conversion Alteration Abandonment

(2a) PRE-ALTERATION

Casing: Dia From To Gauge Stl Plstc Wld Thrd Seal: Material From To Amt sacks/lbs

(3) DRILL METHOD

Rotary Air Rotary Mud Cable Auger Cable Mud Reverse Rotary Other

(4) PROPOSED USE

Domestic Irrigation Community Industrial/ Commercial Livestock Dewatering Thermal Injection Other

(5) BORE HOLE CONSTRUCTION

Depth of Completed Well 423 ft. Special Standard (Attach copy)

Table with columns: Dia, From, To, Material, SEAL, Amt, lbs. Rows include Bentonite and Cement.

How was seal placed: Method A B C D E

Backfill placed from 423 ft. to 427 ft. Material Pea Gravel

Filter pack from 236 ft. to 423 ft. Material CSS Size 6/9

Seal Placement Begin Date 12/15/2023 Begin Time 11:00

(5a) ABANDONMENT USING UNHYDRATED BENTONITE

Proposed Amount Pounds Actual Amount Pounds

(6) CASING/LINER

Table with columns: Casing/Liner, Dia, From, To, Gauge, Stl, Plstc, Wld, Thrd. Rows for Riser and Tail.

Shoe Inside Outside Other Location of shoe(s) 423

Temp casing Yes Dia 20 From + 3 To 51

(7) PERFORATIONS/SCREENS

Perforations Method Screens Type V-Wire Material Stainless Steel

Table with columns: Perf/Sreen, Casing/Screen, Dia, From, To, Sern/slot width, Slot length, # of slots, Tele/pipe size.

(8) WELL TESTS: Minimum testing time is 1 hour

Pump Bailer Air Flowing Artesian

Table with columns: Yield gal/min, Drawdown, Drill stem/Pump depth, Duration (hr). Row: 900, 30, 273, 8.

Temperature 56 °F Lab analysis Yes By

Water quality concerns? Yes (describe below) TDS amount 214 ppm

Table with columns: From, To, Description, Amount, Units.

(9) LOCATION OF WELL (legal description)

County CLACKAMAS Twp 2 S N/S Range 4 E E/W WM Sec 7 NE 1/4 of the NE 1/4 Tax Lot 100

Street address of well Nearest address

29760 SE Kelso Rd, Boring, OR 97009

(10) STATIC WATER LEVEL

Table with columns: Existing Well / Pre-Alteration, Date, SWL(psi), SWL(ft). Row: Completed Well 01-25-2024 198' 8 1/4"

Flowing Artesian? Dry Hole?

WATER BEARING ZONES

Depth water was first found 26

Table with columns: SWL Date, From, To, Est Flow, SWL(psi), SWL(ft). Rows for 07-25-2023 and 01-25-2024.

(11) WELL LOG

Ground Elevation

Table with columns: Material, From, To. Rows include Soil, Clay Brown/Red with occasional Cobbles with Brown Clay, Cemented Gravel, etc.

Construction Begin Date 07-21-2023 Begin Time 08-11:00 End Date 01-31-2024

(unbonded) Water Well Constructor Certification

I certify that the work I performed on the construction, deepening, alteration, or abandonment of this well is in compliance with Oregon water supply well construction standards.

License Number Date

Signed

(bonded) Water Well Constructor Certification

I accept responsibility for the construction, deepening, alteration, or abandonment work performed on this well during the construction dates reported above.

License Number 88 Date 02-05-2024

Signed Steven M. Staschi

Contact Info (optional)

WATER SUPPLY WELL REPORT -
 continuation page

WESTERBERG DRILLING IN NOVELL I.D. LABEL# L151651

PO BOX 1228

START CARD # 1070460

MOLALLA, OR 97038

ORIGINAL LOG #

(2a) PRE-ALTERATION

Dia	+	From	To	Gauge	Std	Plstc	Wld	Thrd

Material	From	To	Amt	sacks/lbs

(5) BORE HOLE CONSTRUCTION

BORE HOLE				SEAL				sacks/ lbs
Dia	From	To	Material	From	To	Amt		
						Calculated		
						Calculated		
						Calculated		
						Calculated		

FILTER PACK

From	To	Material	Size

(6) CASING/LINER

Casing Liner Dia + From To Gauge Std Plstc Wld Thrd

○					○			
○					○			
○					○			
○					○			
○					○			
○					○			
○					○			
○					○			
○					○			
○					○			

(7) PERFORATIONS/SCREENS

Perf/S Casing/ Screen
 creen Liner Dia From To Scrn/slot Slot # of Tele/
 width length slots pipe size

Water Quality Concerns

From	To	Description	Amount	Units

(10) STATIC WATER LEVEL

SWL Date	From	To	Est Flow	SWL(psi)	+ SWL(ft)

(11) WELL LOG

Material	From	To
Sandstone Conglomerate	281	301
Course Sand, Small Gravel Loosely Cemented	301	332
Cemented Gravel w/Sand Brown w/Carmel Gravel	332	366
Sand Brown/Yellow Medium with Few Gravels	366	372
Clay Tan	372	383
Clay Grey	383	393
Sand Grey with Clay Lenses & Layers of Sand & Gravel Black	393	407
Sandstone/Grave/Conglomerate Black	407	414
Clay Grey	414	427

Received

FEB 12 2024

OWRD

Name of person(s) who assisted with construction and Trainee License # / Helper #

Assistant Name	Type	#
Mike Hamilton		
Cody Stephenson		

Comments/Remarks

12" x 10" bell reducer welded between 12" riser pipe and 10" screen at 274' - 275'.
 Bottom plate welded on tail pipe.
 12" flush drive shoe on top of 12" riser pipe.
No drilling occurred after completed SWL date
 This well was drilled for Water Right Permit G-11134 & T-13802 & T-10751

(8) WELL TESTS: Minimum testing time is 1 hour

Yield gal/min Drawdown Drill stem/Pump depth Duration (hr)



Owner Information:

OWRD

OWNER NAME/BUSINESS NAME: Iseli Nursery / Greg Elwell		PHONE NO.: 971-400-6053	ADDITIONAL CONTACT NO.:
ADDRESS: 30590 SE Kelso Rd.			
CITY: Boring	STATE: OR	ZIP: 97009	E-MAIL: gelwell@iselinursery.com

Pump Test Conducted By (If Different From Owner):

TEST CONDUCTED BY NAME: Steve Stadeli	QUALIFICATION: (SELECT) WWC	LICENSE #: 688	
COMPANY: Westerberg Drilling, Inc.	PHONE NO.: 503-829-2526	ADDITIONAL CONTACT NO.:	
ADDRESS: PO Box 1228			
CITY: Molalla	STATE: OR	ZIP: 97038	E-MAIL: wdi.rsi@gmail.com

Tested Well Information (please attach well log(s) if available):

WELL LOG # (EX: MARI 99999)	WELL TAG # (EX: L-99999)	WELL NAME OR #	WELL DEPTH	ORIGINAL OWNER	DATE DRILLED	TEST DATE
	L- 151651	#9	423	Iseli Nursery	01/31/2024	01/25/2024

(CONTINUED)

TWP (EX: 25S)	RNG (EX: 31E)	SEC (EX: 12)	QQ (EX: SE/SW)	SURVEYED LOCATION (EX: 100 FT N & 735 FT E fr SE cor, sec 5)	LATITUDE (EX: 44.94473859)	LONGITUDE (EX: -123.02787000)
2S	4E	7	NE/NE		45.417948	-122.354776

List all water rights for which you are submitting this test. Please indicate if the tested well is listed as an authorized source of water on each water right. If not, you may also need to fill out a multiple well exemption (MWE) request form.

APPLICATION	PERMIT	TRANSFER	CERTIFICATE	IS THE TESTED WELL AN AUTHORIZED POA ON THIS RIGHT?
G-	G-	T-		<input type="radio"/> Yes <input checked="" type="radio"/> No (Need MWE Form)
G-	G-	T-		<input type="radio"/> Yes <input checked="" type="radio"/> No (Need MWE Form)
G-	G-	T-		<input type="radio"/> Yes <input checked="" type="radio"/> No (Need MWE Form)

Nearby Wells and Streams: Please check yes or no. Do not leave blank.

No Are there any wells, other than domestic or stock wells, within 1000 feet of the tested well?
If yes, identify the well by OWRD log number or attach a copy of the well log. Note the approximate distance to each well from the tested well and the approximate pumping rate of each.
If possible, indicate if they were turned on or off during the test or within 24 hours prior to the test (Indicate Not Pumped, if applicable).

WELL LOG # (EX: MARI 99999)	BEARING & DISTANCE FROM PUMPED WELL (FT)	DATE & TIME PUMP ON	DATE & TIME PUMP OFF	PUMPING RATE (GPM)

No Is there a lake, stream or other surface water body within 1/4 mile of the tested well?
If yes, give approximate distance from the well and approximate elevation difference between the surface water and the well head. Approximate distance: _____ ft.
Well elevation is above the surface water body. Approximate elevation difference: _____ ft.

Yes Was the test conducted during normal use of the well?
Please indicate where pumped water was discharged: Nursery Holding & Distribution Pond
How far from the pumped well was water discharged? Approximately 1/2 Mile _____ ft.



Water-Level Measurement Method: Electric Tape *Verify here: { **Airline:** _____ psi _____ feet.
Length of air line (if used): _____ { **E-Tape:** _____ feet.

*Airline measurements must be verified by an E-Tape measurement

Pressure transducer (if used):
Manufacturer: _____ **Serial #:** _____
Date Last Calibrated: _____ **Units:** _____

Pump Type: Submersible
HP: 100 **Pump set at:** 273 feet.
Pump idle time: 38 Hours

Discharge Measurement Method: Flowmeter
Flowmeter (if used):
Manufacturer: McCrometer **Serial #:** _____
Date Last Calibrated: Not Known **Units:** Gallons

Note: Well must be idle for at least 16 hours prior to the test. Additional forms can be obtained from our web site at:
<https://www.oregon.gov/OWRD/Forms/Pages/default.aspx>

Measuring Point (MP): Measuring point distance above land surface 5.0 feet.
Description (e.g., top port of 1 inch port pipe, west side) Top 3/4" PVC probe tube at well head.

Time pump turned on: Date 01/25/2024 Time 8:00 AM
Time pump turned off: Date 01/25/2024 Time 4:00 PM
Total pumping time: 8 hours 0 minutes.

Remember, your pump test may not be approved unless it meets the following criteria*:

- The discharge rate was held constant for the entire pumping phase.
- The pump was on during the entire pumping phase (≥ 4 hours).
- The discharge was measured at the start of pumping and at least once every hour during the test.
- Water levels were measured to an accuracy of 0.1 feet or 0.5 percent.
- Pre-test static water levels were measured at least three times in the hour before pumping began at no less than 20 minutes apart.
- Water levels were measured at the specified intervals during the pumping phase of the test for at least four hours (≤2 min for the first 10 minutes, ≤5 min for 10 – 30 minutes, and ≤15 min for the remainder of the test)
- Water levels were measured at the specified intervals (see above) during the recovery phase of the test for four hours or until 90 percent of the maximum drawdown has recovered.
- If using an airline, measurements were calibrated with an E-Tape and the depth to water was ≥ 300 feet.
- The pump test cover sheet was completely filled out and signed.
- The pumping rate was as close as reasonably possible to the (anticipated) pumping rate during normal use of the well.
- The well was idle for at least 16 hours prior to the test.
- The pump test was completed by an acceptably qualified person (Oregon licensed water well constructors; Oregon registered professional geologists or certified engineering geologists; certified water rights examiners; Oregon registered professional engineers; and individuals whose primary occupation involves, wholly or in significant part, pump installation, service, or testing).

*This checklist is intended for information purposes only and does not guarantee a pump test approval. The Department reserves all authority pertaining to the implementation of the rules under OAR 690-217.

Pump tests are intended to provide aquifer and well information for ground water resource characterization and to help solve well problems (OAR 690-217-0015(9)).

Pump test requirements for OAR 690-217 can be found online at:
https://secure.sos.state.or.us/oard/displayDivisionRules.action;JSESSIONID_OARD=1BdwLynsYAPNSQtW330ZjSFZuMscp4Hfl-1fsDAAEsMC2_ROSs!-277278532?selectedDivision=3186.

Submit forms to: **Attn: Certificates Section, Oregon Water Resources Department**
725 Summer St NE Suite A, Salem, OR 97301

Forms may additionally be sent to WRD_DL_pumptestsupport@oregon.gov

I hereby certify that this test has been conducted in accordance with OAR 690-217:

OPERATOR SIGNATURE: Steven N. Stadel **DATE:** 02/07/2024

OWNER SIGNATURE: _____ **DATE:** _____



OWRD

WELL LOG # (EX: MARI 99999)	WELL TAG # (EX: L-999999)	WELL NAME OR #	WELL DEPTH	ORIGINAL OWNER	DATE DRILLED	TEST DATE
	L- 151651	#9	423	Iseli Nursery	01/31/2024	01/25/2024

Date	Time	Time Since Pumping Started (min)	Depth to Water Below MP	Discharge Rate (gpm, cfs, gpm)	Phase (Pre-Test, Pumping, Recovery)	Airline or Shut-in Pressure (psi)	Flowmeter Reading (if available)	Comments
01/25/24	7:05 AM		203' 8.5"	0	Pre-test			
	7:25		203' 8.5"	0	Pre-test			
	7:45		203' 8.5"	0	Pre-test			
	8:00			900	Pumping			Start Pump
	8:02	2 Min	215' 6.25"	900	Pumping			
	8:04	4 Min	218' 11.25"	900	Pumping			
	8:06	6 Min	220' 0.5"	900	Pumping			
	8:08	8 Min	221' 0.75"	900	Pumping			
	8:10	10 Min	221' 3.75"	900	Pumping			
	8:15	15 Min	222' 6.25"	900	Pumping			
	8:20	20 Min	224' 0.25"	900	Pumping			
	8:25	25 Min	225' 1.5"	900	Pumping			
	8:30	30 Min	225' 9.75"	900	Pumping			
	8:45	45 Min	226' 11.75"	900	Pumping			
	9:00	1 Hour	227' 9"	900	Pumping			
	9:15	1 H 15 M	228' 4"	900	Pumping			
	9:30	1 H 30 M	228' 9.5"	900	Pumping			
	9:45	1 H 45 M	229' 2"	900	Pumping			
	10:00	2 Hours	229' 7.25"	900	Pumping			
	10:15	2 H 15 M	229' 10"	900	Pumping			
	10:30	2 H 30 M	230' 3.75"	900	Pumping			
	10:45	2 H 45 M	230' 6.75"	900	Pumping			
	11:00	3 Hours	230' 9.5"	900	Pumping			
	11:15	3 H 15 M	231'	900	Pumping			
	11:30	3 H 30 M	231' 2.75"	900	Pumping			
	11:45	3 H 45 M	231' 5.5"	900	Pumping			
	12:00	4 Hours	231' 6.75"	900	Pumping			
	12:15	4 H 15 M	231' 10.25"	900	Pumping			
	12:30	4 H 30 M	232' 0.5"	900	Pumping			
	12:45	4 H 45 M	232' 0.75"	900	Pumping			
	1:00	5 Hours	232' 4.5"	900	Pumping			
	1;15	5 H 15 M	232' 6"	900	Pumping			
	1:30	5 H 30 M	232' 7.75"	900	Pumping			
	1:45	5 H 45 M	232' 9.5"	900	Pumping			
	2:00	6 Hours	232' 10"	900	Pumping			
	2:15	6 H 15 M	232' 11.5"	900	Pumping			
	2:30	6 H 30 M	233' 1.75"	900	Pumping			
	2:45	6 H 45 M	233' 2.75"	900	Pumping			
	3:00	7 Hours	233' 5"	900	Pumping			




WELL LOG # (EX: MARI 99999)	WELL TAG # (EX: L-99999)	WELL NAME OR #	WELL DEPTH	ORIGINAL OWNER	DATE DRILLED	TEST DATE
	L- 151651	#9	423	Iseii Nursery	01/31/2024	01/25/2024

Date	Time	Time Since Pumping Started (min)	Depth to Water Below MP	Discharge Rate (gpm, cfs, gpm)	Phase (Pre-Test, Pumping, Recovery)	Airline or Shut-in Pressure (psi)	Flowmeter Reading (if available)	Comments
01/25/24	3:15 PM	7 H 15 M	233' 6.5"	900	Pumping			
	3:30	7 H 30 M	233' 7.25"	900	Pumping			
	3:45	7 H 45 M	233' 8.5"	900	Pumping			
	4:00	8 Hours	233' 9.25"	900	Pumping			Pump Off
	4:02	2 Min	219' 2"	0	Recovery			
	4:04	4 Min	216' 10"	0	Recovery			
	4:06	6 Min	216' 0.5"	0	Recovery			
	4:08	8 Min	215' 3.75"	0	Recovery			
	4:10	10 Min	214' 6.5"	0	Recovery			
	4:15	15 Min	213' 3.5"	0	Recovery			
	4:20	20 Min	212' 5.5"	0	Recovery			
	4:25	25 Min	211' 11.5"	0	Recovery			
	4:30	30 Min	211' 4.75"	0	Recovery			
	4:45	45 Min	210' 7.5"	0	Recovery			
	5:00	1 Hour	210'	0	Recovery			
	5:15	1 H 15 M	209' 7"	0	Recovery			
	5:30	1 H 30 M	209' 2.5"	0	Recovery			
	5:45	1 H 45 M	208' 11"	0	Recovery			
	6:00	2 Hours	208' 8"	0	Recovery			
	6:15	2 H 15 M	208' 4.5"	0	Recovery			
	6:30	2 H 30 M	208' 2.5"	0	Recovery			
	6:45	2 H 45 M	208' 0.75"	0	Recovery			
	7:00	3 Hours	207' 10.25"	0	Recovery			
	7:15	3 H 15 M	207' 8.5"	0	Recovery			
	7:30	3 H 30 M	207' 6.5"	0	Recovery			
	7:45	3 H 45 M	207' 4.5"	0	Recovery			
	8:00	4 Hours	207' 2.5"	0	Recovery			
	8:15	4 H 15 M	207' 1.25"	0	Recovery			
	8:30	4 H 30 M	206' 11.75"	0	Recovery			
	8:45	4 H 45 M	206' 10.5"	0	Recovery			
	9:00	5 Hours	206' 9"	0	Recovery			
	9:15	5 H 15 M	209' 7.25"	0	Recovery			
	9:30	5 H 30 M	206' 5.75"	0	Recovery			
	9:45	5 H 45 M	206' 7.5"	0	Recovery			
	10:00	6 Hours	206' 3.5"	0	Recovery			
	10:15	6 H 15 M	206' 2.75"	0	Recovery			
	10:30	6 H 30 M	206' 2"	0	Recovery			
	10:45	6 H 45 M	206' 1.25"	0	Recovery			
	11:00	7 Hours	206' 0.75"	0	Recovery			

ISREI NURSERY WELL # 9

L-157651

16"

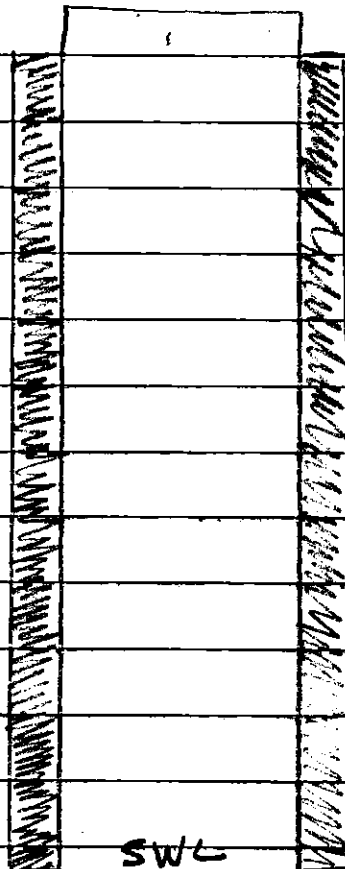

← BENTONITE 0-16
-16 FT

Received

FEB 12 2024

OWRD

← 20" BOREHOLE AND
CEMENT GROUT 16'-195'

SWL
198-5 1/4"

195 BOTTOM OF CEMENT GROUT SEAL

12" BLANK RISER PIPE

12" → 234

10" X 10" CONCENTRIC REDUCER
274
275

10" → 280 FT BOTTOM OF 16" CASING

10" P.S. X.070 SCREEN
(276' - 372')

← 16" BOREHOLE TO 423 FT

10" BLANK CASING

372

10" P.S. X.070 SCREEN
(392' - 415')

- 392

10" BLANK TAIL PIPE

415

423 BOTTOM OF WELL

NOTE:

6/9 SILICA SAND

FILTER PACK (236' - 423')