

STATE ENGINEER
Salem, Oregon

Well Record

STATE WELL NO. 3/1W-5P
COUNTY Clackamas
APPLICATION NO. GR-3477

CLAC 07865

OWNER: Geo. L. Merz and/or Maude A. Merz MAILING ADDRESS: Route 2, Box 268

LOCATION OF WELL: Owner's No. CITY AND STATE: Sherwood, Oregon


SE 1/4 SW 1/4 Sec. 5 T. 3 S. R. 1 W., W.M.

Bearing and distance from section or subdivision
corner 29.86 chains E. and 18.52 chains N.

Altitude at well

TYPE OF WELL: drilled Date Constructed 1953

Depth drilled 155' Depth cased 155'

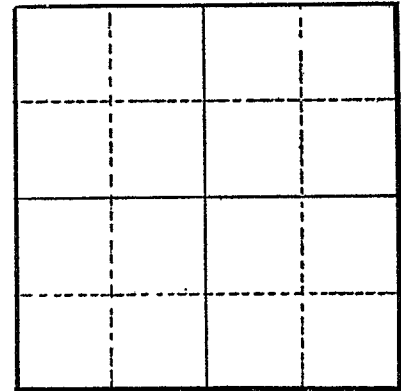

Section

CASING RECORD:

6"

FINISH:

AQUIFERS:

Loam and rock

WATER LEVEL:

92'

PUMPING EQUIPMENT: Type Johnston Turbine H.P. 5
Capacity 25 G.P.M.

WELL TESTS:

Drawdown 32 ft. after hours pumping 30 G.P.M.
Drawdown ft. after hours G.P.M.

USE OF WATER Irrigation Temp. °F. 19

SOURCE OF INFORMATION GR-3211

DRILLER or DIGGER Steinman Brothers, Milwaukie, Oregon

ADDITIONAL DATA:

Log x Water Level Measurements Chemical Analysis Aquifer Test

REMARKS:

Olympic shot loam (no water) 39' 39'
Hard rock (water bearing from 92' to bottom) 116'