

6/2/2026

START CARD #

1082242

ORIGINAL LOG #

(2a) PRE-ALTERATION

Dia	+	From	To	Gauge	Stl	Plstc	Wld	Thrd
								
								
								

Material	From	To	Amt	sacks/lbs

(5) BORE HOLE CONSTRUCTION

BORE HOLE			SEAL			sacks/ lbs	
Dia	From	To	Material	From	To		Amt
					Calculated		
					Calculated		
					Calculated		
					Calculated		

FILTER PACK		Material	Size
From	To		

(6) CASING/LINER

[illegible]

(7) PERFORATIONS/SCREENS

[illegible]

(8) WELL TESTS: Minimum testing time is 1 hour

Type of Test	Yield (gal/min)	Drawdown	Drill Stem/ Pump Depth	Duration (hr)

Water Quality Concerns

From	To	Description	Amount	Units

(10) STATIC WATER LEVEL

[illegible]

(11) WELL LOG

[illegible]

Name of person(s) who assisted with construction and Trainee License # / Helper #

Assistant Name	Type	#

Comments/Remarks


Depth of well was 220 ft. Perforated 6in well casing from top to bottom.
Pumped full of cement. Calculated to take 323 gallons, pumped 385 gallons..

WATER SUPPLY WELL REPORT - Map with location identified must be attached and shall include an approximate scale and north arrow

CLAC 79807

6/2/2026

Map of Hole

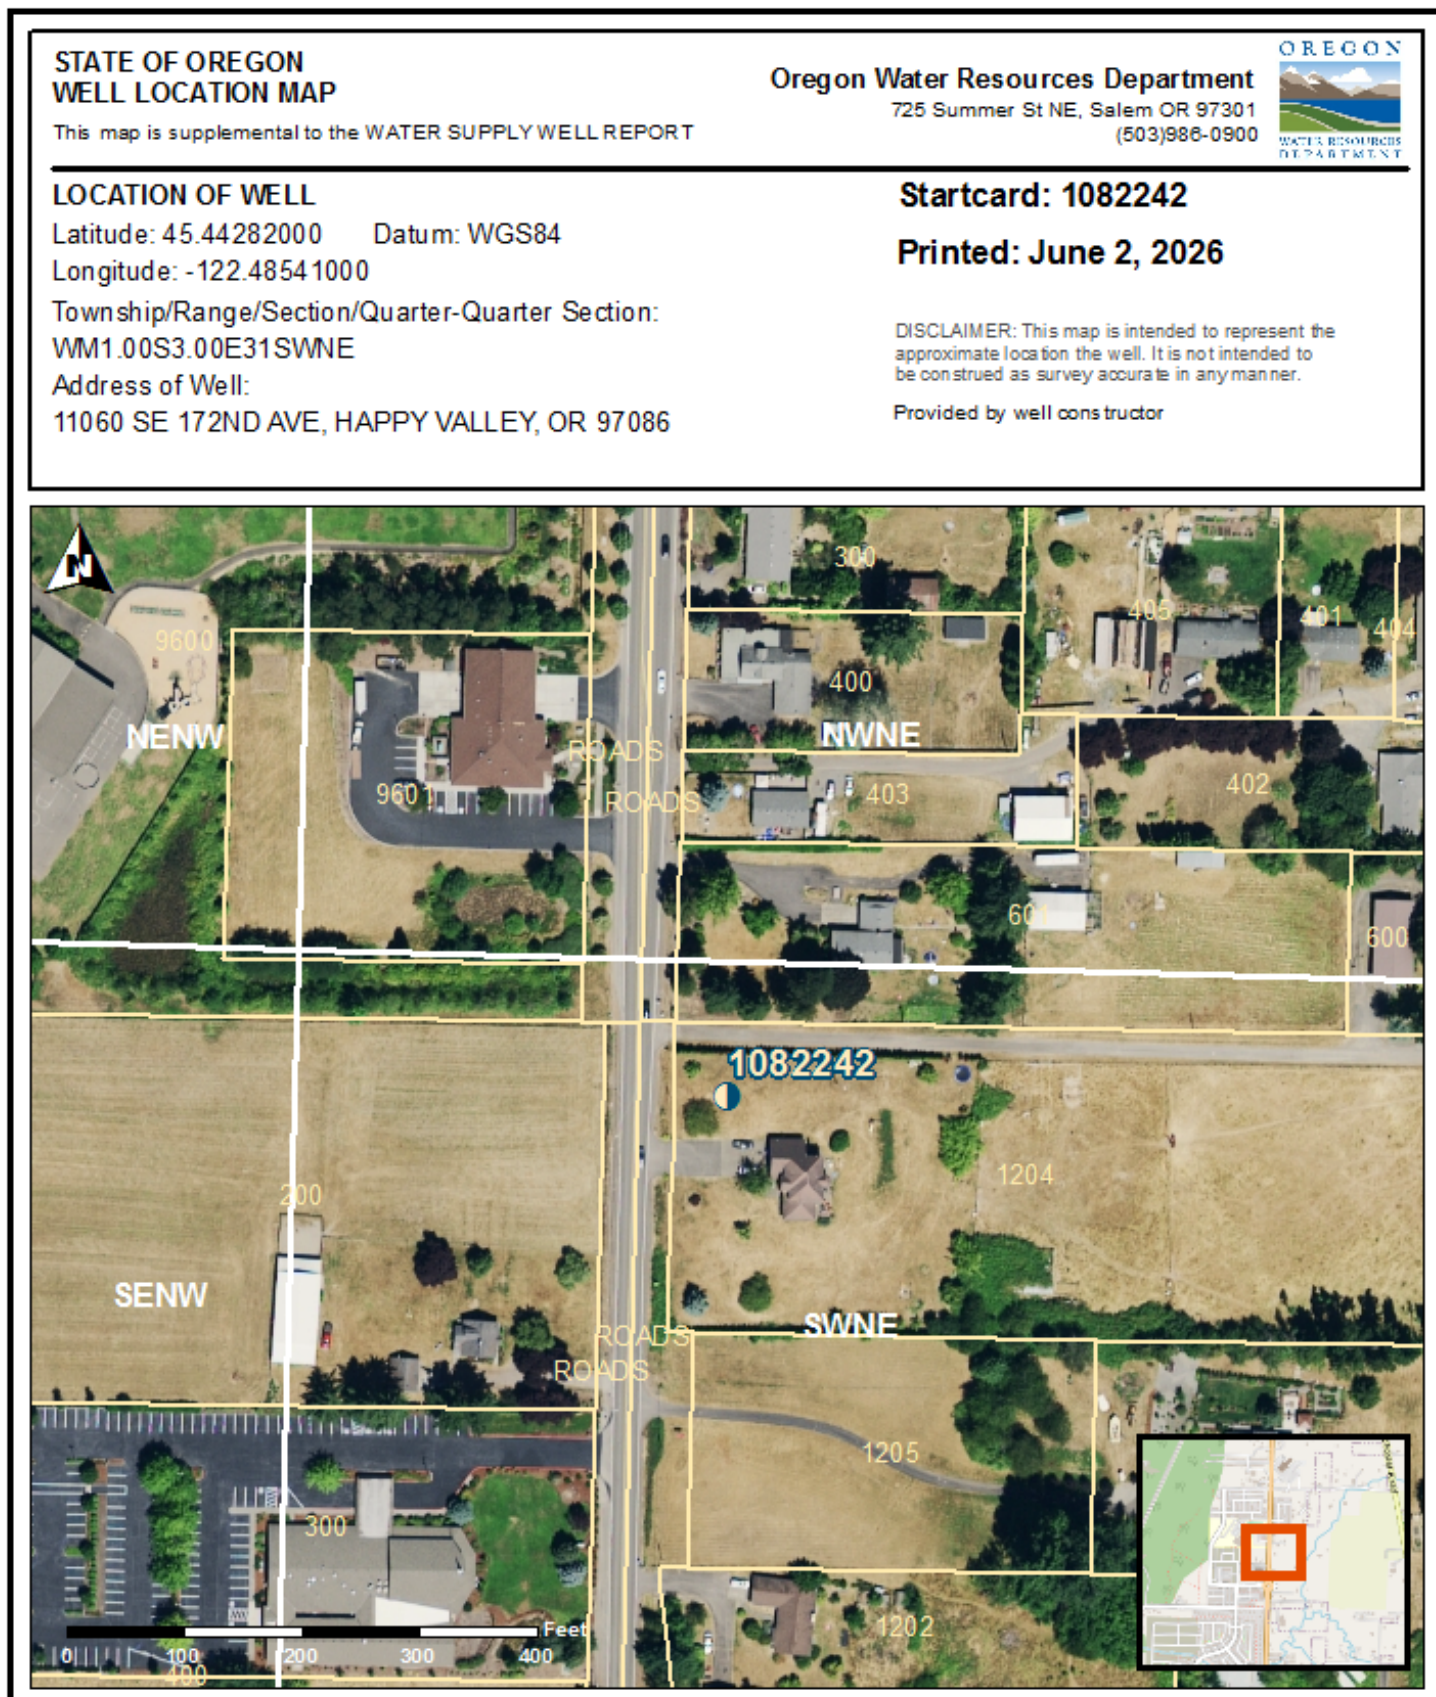

6/2/2026

Map of Hole

