


WATER SUPPLY WELL REPORT - Map with location identified must be attached and shall include an approximate scale and north arrow

CLAC 79809

6/2/2026

Map of Hole

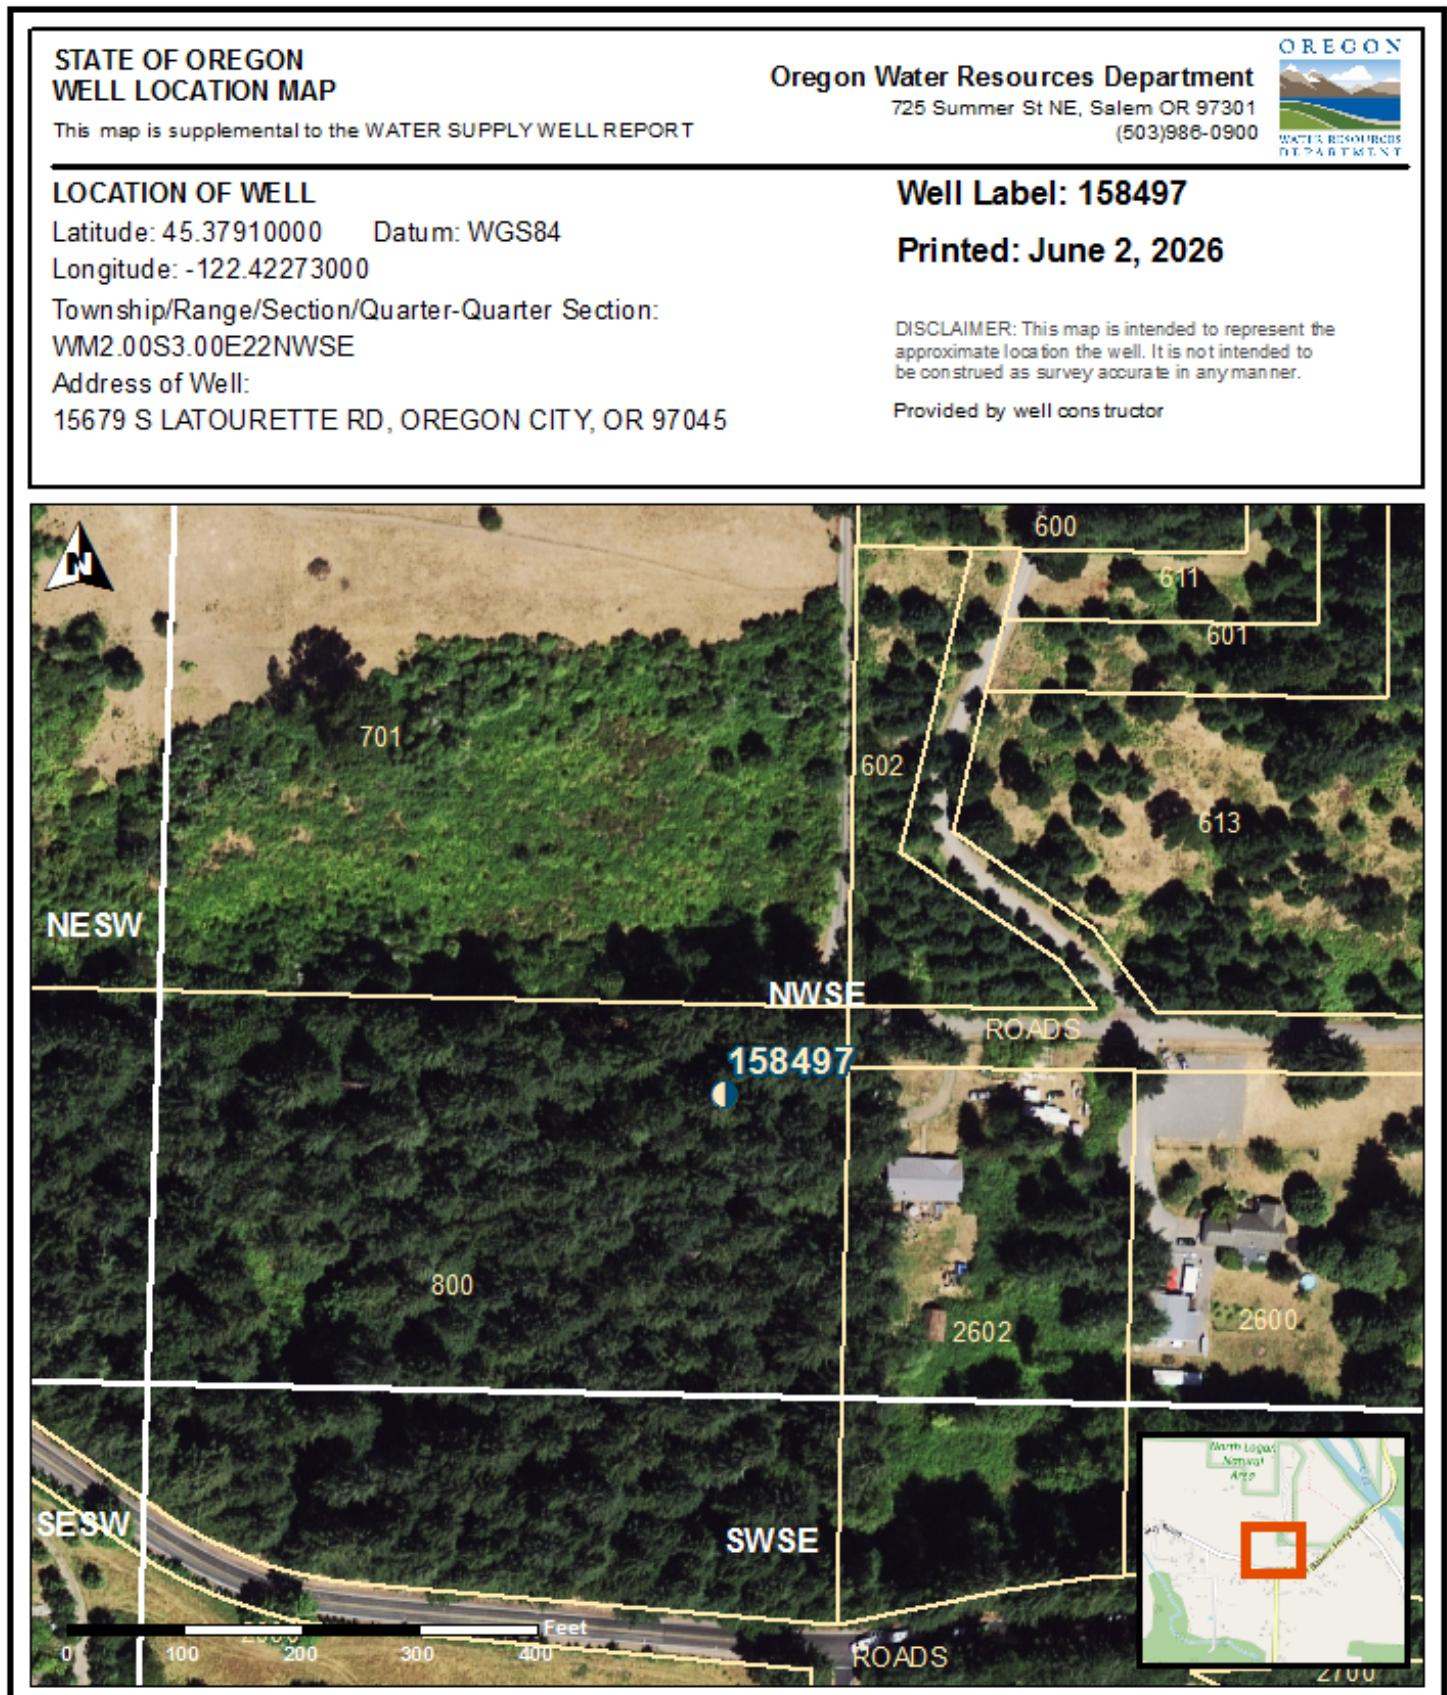

6/2/2026

Map of Hole

