

New exempt use wells must be submitted with a map and recording fee.


Hand dug well was 60" in diameter 40ft depth. 40ft to 30ft filled with clean fill. 30ft to 5ft pumped full of 17 yards of concrete. 5ft to surface filled with clean fill to accommodate finished grade. Bottom of well got smaller with depth. Special standard #36953

WATER SUPPLY WELL REPORT - Map with location identified must be attached and shall include an approximate scale and north arrow

CLAC 79953

8/14/2026

## Map of Hole

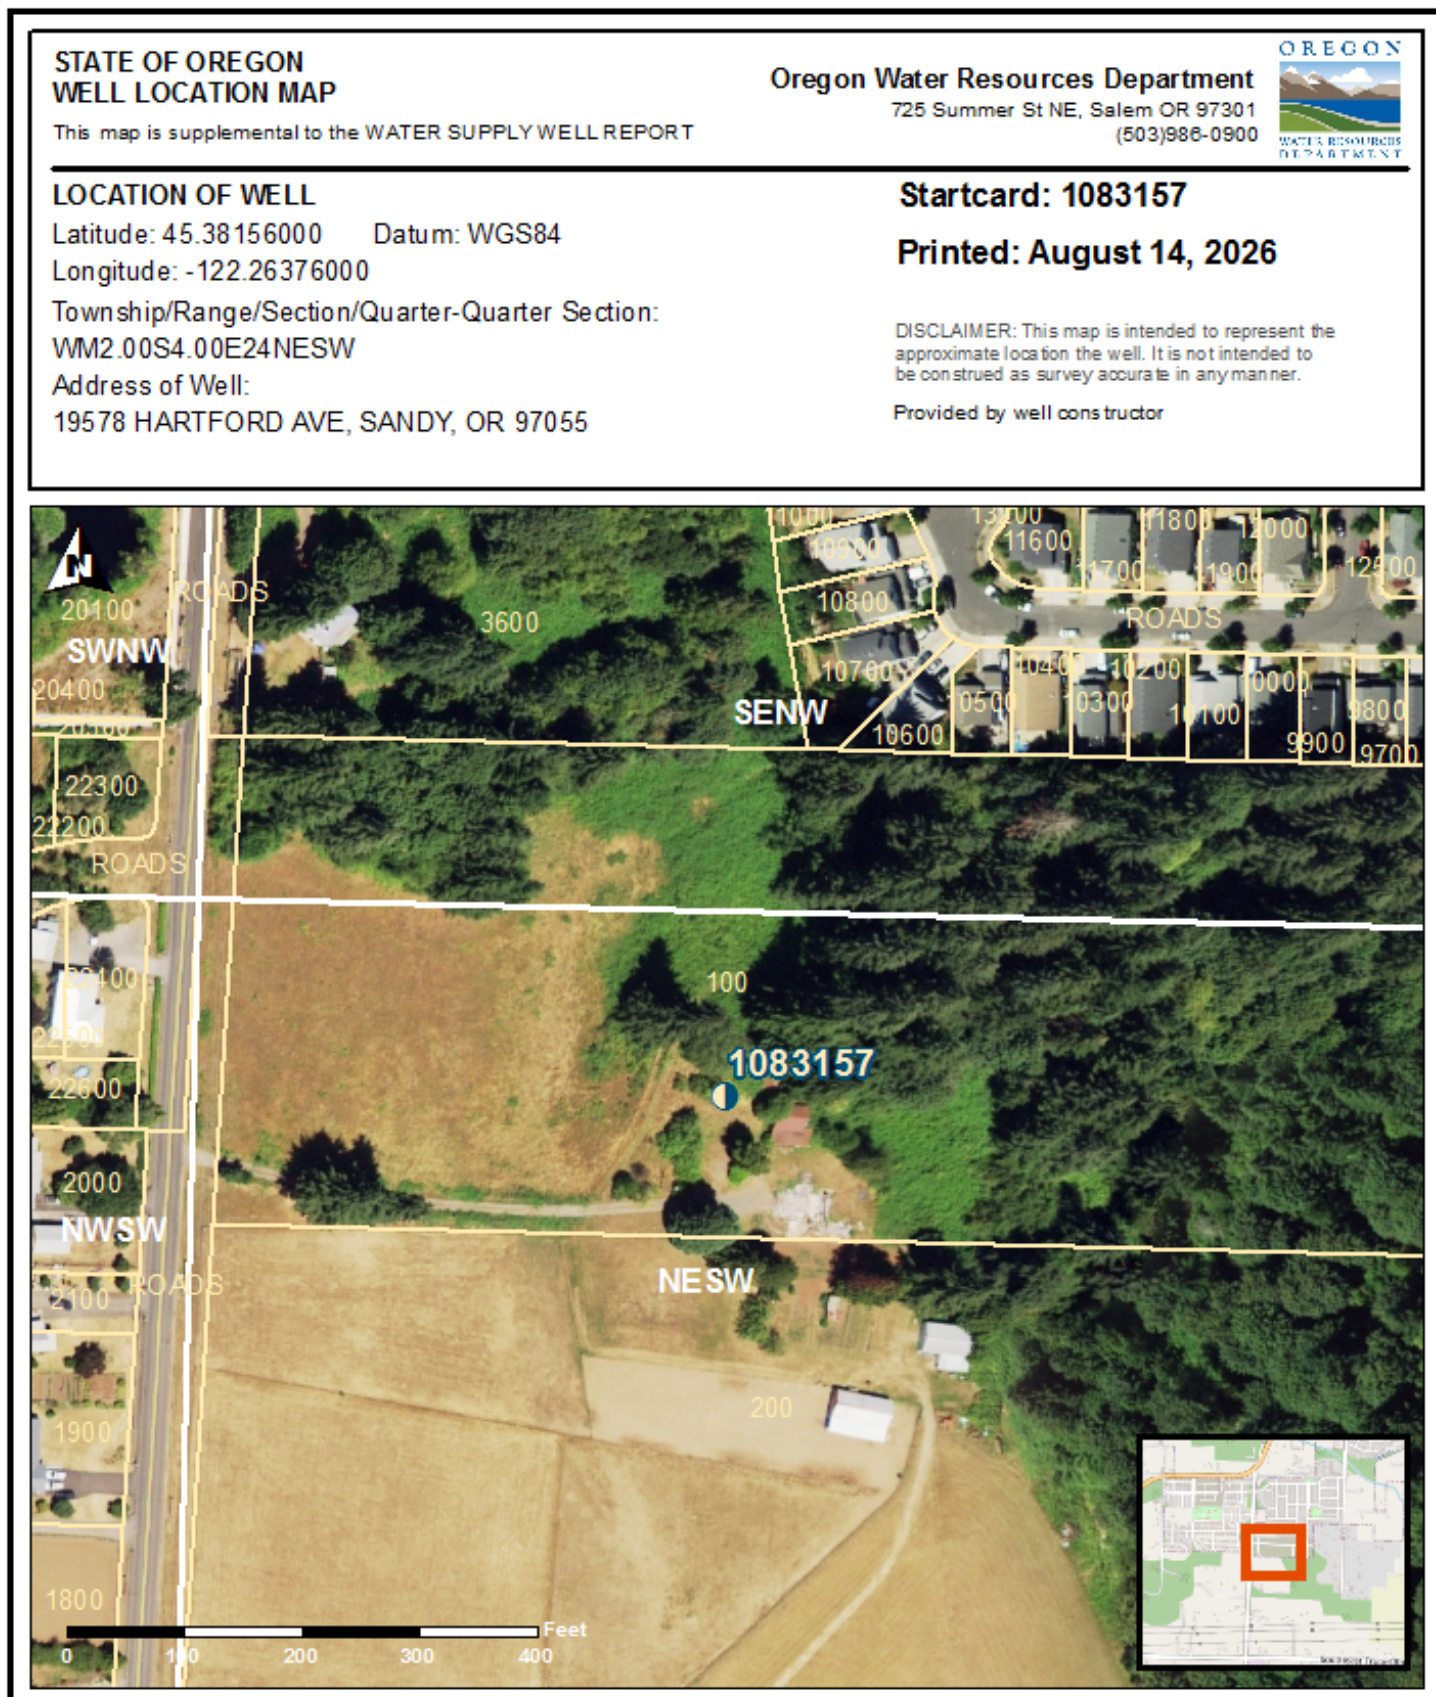

8/14/2026

## Map of Hole

