

STATE ENGINEER
Salem, Oregon

CLAC Well Record

STATE WELL NO. 3/W-10K
COUNTY Clackamas
APPLICATION NO. GR-3600

OWNER: G. Selander & Sons 8006


MAILING ADDRESS: Route 2, Box 158

LOCATION OF WELL: Owner's No.

CITY AND STATE: Sherwood, Oregon

NW 1/4 SE 1/4 Sec. 10 T. 3 S., R. 1 W., W.M.

Bearing and distance from section or subdivision
corner N. 32° W. 1030' from SE corner Sec. 10

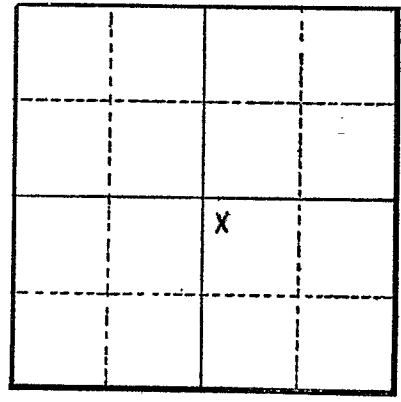

Section 10

Altitude at well

TYPE OF WELL: Dug Date Constructed before 1930

Depth drilled 21 feet Depth cased 21 feet

CASING RECORD:

36 inch casing set from surface to 21 feet

FINISH:

AQUIFERS:

WATER LEVEL:

18 feet below surface

PUMPING EQUIPMENT: Type Bingham centrifugal H.P. 15
Capacity 250 G.P.M.

WELL TESTS:

Drawdown 3 ft. after 300 hours G.P.M.
Drawdown 3 ft. after 150 hours G.P.M.

USE OF WATER Irrigation Temp. °F. 19

SOURCE OF INFORMATION Well Registration Statement

DRILLER or DIGGER

ADDITIONAL DATA:

Log Water Level Measurements Chemical Analysis Aquifer Test

REMARKS: