

STATE ENGINEER
Salem, Oregon

Observation well?
Well Record

STATE WELL NO. 3/1W-10F
COUNTY CLACKAMAS
APPLICATION NO. GR-3712

CLAC
08007

OWNER: Kenneth F. Miller


MAILING ADDRESS: Rt2, Box 157

LOCATION OF WELL: Owner's No. _____

CITY AND STATE: Sherwood, Oregon

SE 1/4 NW 1/4 Sec. 10 T. 3 S., R. 1 W., W.M.

Bearing and distance from section or subdivision corner N 250' & W 20' from center of Section 10

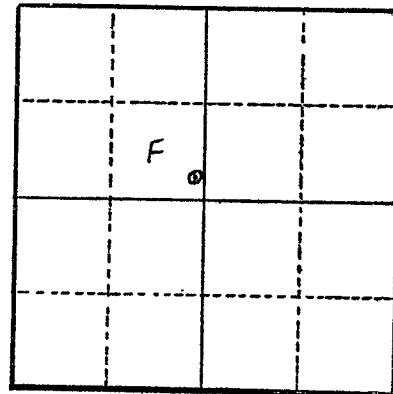

Section 10

Altitude at well _____

TYPE OF WELL: Drilled Date Constructed 1951

Depth drilled 110' Depth cased 110'

CASING RECORD:

6-inch

FINISH: _____

AQUIFERS: _____

WATER LEVEL:

96'

PUMPING EQUIPMENT: Type Dorward Jet

Capacity 15 G.P.M.

H.P. 1 1/2

WELL TESTS:

Drawdown Unk ft. after _____ hours 15 G.P.M.

Drawdown _____ ft. after _____ hours _____ G.P.M.

USE OF WATER Irrigation

Temp. _____ °F. _____, 19____

SOURCE OF INFORMATION GR-3879

DRILLER or DIGGER _____

ADDITIONAL DATA:

Log NA Water Level Measurements _____ Chemical Analysis _____ Aquifer Test _____

REMARKS: _____