

STATE ENGINEER
Salem, Oregon

CLAC
08077

Well Record

STATE WELL NO. 3/1W-12J
COUNTY Clackamas
APPLICATION NO. GR-1467

GR- 1416

OWNER: Floyd F. Tapfer


MAILING ADDRESS: Rt. 1, Box 355

LOCATION OF WELL: Owner's No.

CITY AND STATE: Sherwood, Oregon

NE 1/4 SE 1/4 Sec. 12 T. 3 N. S., R. 1 W., W.M.

Bearing and distance from section or subdivision
corner 2250' N. & 1150' W. from SE cor. Sec. 12

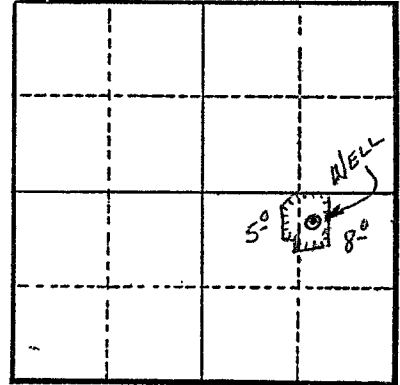

Section 12

Altitude at well 250'

TYPE OF WELL: Drilled Date Constructed 1952

Depth drilled 250' Depth cased 135'

CASING RECORD:

6"

FINISH:

Perforated from 130' to 135' (These perforations have been cemented closed)

AQUIFERS:

WATER LEVEL:

54'

PUMPING EQUIPMENT: Type Jacuzzi jet H.P. 3
Capacity 50 G.P.M.

WELL TESTS:

Drawdown _____ ft. after _____ hours _____ G.P.M.
Drawdown _____ ft. after _____ hours _____ G.P.M.

USE OF WATER Irrigation Temp. _____ °F., 19

SOURCE OF INFORMATION GR Record

DRILLER or DIGGER Steinman Bros.

ADDITIONAL DATA:

Log N.A. Water Level Measurements _____ Chemical Analysis _____ Aquifer Test _____

REMARKS:

Rock encountered at 135'

Irrigation of 13 acres.