

STATE ENGINEER  
Salem, Oregon

CLAC

08150

# Well Record

STATE WELL NO. 3/1W-14L  
COUNTY Clackamas  
APPLICATION NO. CR-3711

OWNER: Ward R. Sealy

MAILING

ADDRESS:

CITY AND

STATE:


Wilsonville, Oregon

LOCATION OF WELL: Owner's No.

NE 1/4 SW 1/4 Sec. 14 T. 3 S. R. 1 W., W.M.

Bearing and distance from section or subdivision

corner N. 09 15' W. 1990 ft. from S 1/4 cor. Sec. 14

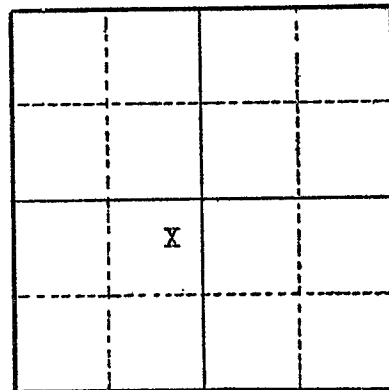

Section 14

Altitude at well

TYPE OF WELL: Drilled Date Constructed 11/5/48

Depth drilled 45 feet Depth cased

## CASING RECORD:

FINISH:

AQUIFERS:

WATER LEVEL:

18 feet below surface

PUMPING EQUIPMENT: Type centrifugal H.P. 25

Capacity 400 G.P.M.

WELL TESTS:

Drawdown 31 ft. after hours 75 G.P.M.

Drawdown ft. after hours G.P.M.

USE OF WATER Irrigation Temp. °F. 19

SOURCE OF INFORMATION Well Registration Statement

DRILLER or DIGGER

ADDITIONAL DATA:

Log X Water Level Measurements Chemical Analysis Aquifer Test

REMARKS:

Log:

Top Soil

Gravel & boulders

Thickness

0 - 4

4 - 45