

STATE ENGINEER
Salem, Oregon

CLAC

8152

Well Record

STATE WELL NO. 3/1W-14N
COUNTY Clackamas
APPLICATION NO. GR-3057

OWNER: Wiedemann Brothers

MAILING

ADDRESS:

CITY AND

STATE: Wilsonville, Oregon

LOCATION OF WELL: Owner's No. _____

SW $\frac{1}{4}$ SW $\frac{1}{4}$ Sec. 14 T. 3 S., R. 1 W., W.M.

Bearing and distance from section or subdivision


corner N. 12° E., 380 ft. from SW Cor. Sec. 14

Altitude at well _____

TYPE OF WELL: Dug Date Constructed 1915 ?

Depth drilled 40 ft. Depth cased _____

CASING RECORD:

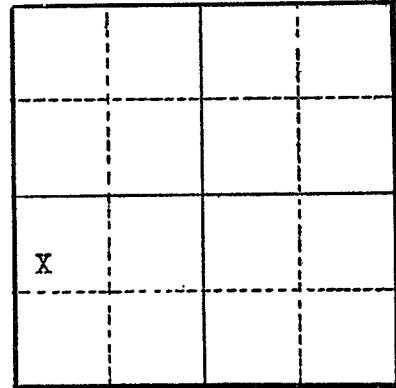

Section 14

FINISH:

AQUIFERS:

WATER LEVEL:

36 feet below surface

PUMPING EQUIPMENT: Type Cook jet H.P. 3/4
Capacity 20 G.P.M.

WELL TESTS:

Drawdown _____ ft. after _____ hours _____ G.P.M.

Drawdown _____ ft. after _____ hours _____ G.P.M.

USE OF WATER Irrigation Temp. _____ °F., 19 _____

SOURCE OF INFORMATION Well Registration Statement Cert. # GR-3790

DRILLER or DIGGER _____

ADDITIONAL DATA:

Log _____ Water Level Measurements _____ Chemical Analysis _____ Aquifer Test _____

REMARKS: