

STATE ENGINEER
Salem, Oregon

CLAC
08154

Well Record

STATE WELL NO. 3/1W-140
COUNTY Clackamas
APPLICATION NO. CR-3612

MAILING ADDRESS: Route 1, Box 344
OWNER: Harold B. Schroeder and Mary C. Schroeder

CITY AND STATE: Wilsonville, Oregon
LOCATION OF WELL: Owner's No. _____

SW $\frac{1}{4}$ SE $\frac{1}{4}$ Sec. 14 T. 3 S., R. 1 W., W.M.

Bearing and distance from section or subdivision


corner Approx. N. 500 ft. W. 375 ft. of SW cor.

of SE $\frac{1}{4}$ SE $\frac{1}{4}$ Sec. 14

Altitude at well _____

TYPE OF WELL: Drilled Date Constructed between 1911 and 1914

Depth drilled over 50 ft. Depth cased over 50 ft.

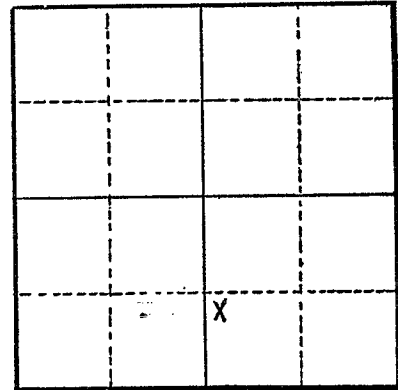

Section 14

CASING RECORD:

6 inch standard well casing set to over 50 feet

FINISH:

AQUIFERS:

WATER LEVEL:

18 feet below surface

PUMPING EQUIPMENT: Type Myers 912 series H.P. 1
Capacity 9 G.P.M.

WELL TESTS:

Drawdown 2 $\frac{1}{2}$ ft. after _____ hours 9 G.P.M.

Drawdown _____ ft. after _____ hours _____ G.P.M.

USE OF WATER Irrigation Temp. _____ °F. _____, 19____

SOURCE OF INFORMATION Well Registration Statement

DRILLER or DIGGER _____

ADDITIONAL DATA:

Log _____ Water Level Measurements _____ Chemical Analysis _____ Aquifer Test _____

REMARKS: