

STATE ENGINEER
Salem, Oregon

Well Record
08460
CLAC

STATE WELL NO. 3/1W-23C
COUNTY Clackamas
APPLICATION NO. GR-3302


OWNER: Frank B. & Myrtle K. Lee

MAILING ADDRESS: Route 2, Box 61-A

LOCATION OF WELL: Owner's No. _____

CITY AND STATE: Sherwood, Oregon

NE $\frac{1}{4}$ NW $\frac{1}{4}$ Sec. 23 T. 3 S., R. 1 W., W.M.

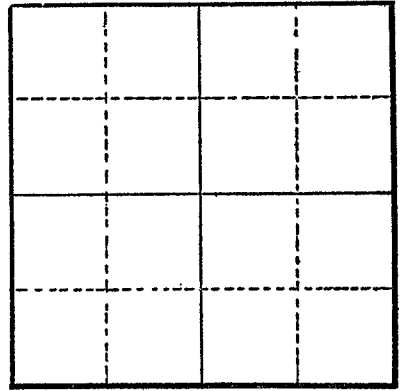

Bearing and distance from section or subdivision corner 300' E. & 240' N. from NW cor. T. Bailey

DLC

Altitude at well _____

TYPE OF WELL: dug Date Constructed 1939

Depth drilled 30 Depth cased 30

Section _____

CASING RECORD:

36 inch

FINISH:

AQUIFERS:

Soil, and gravel sand

WATER LEVEL:

17 feet

PUMPING EQUIPMENT: Type Meyer H.P. 3/4
Capacity 15 G.P.M.

WELL TESTS:

Drawdown _____ ft. after _____ hours _____ G.P.M.
Drawdown _____ ft. after _____ hours _____ G.P.M.

USE OF WATER Irrigation Temp. _____ °F., 19

SOURCE OF INFORMATION GR-3064

DRILLER or DIGGER _____

ADDITIONAL DATA:

Log Water Level Measurements _____ Chemical Analysis _____ Aquifer Test _____

REMARKS:

Soil, 4
Gravel, 13
Sand and gravel