

OWRD Staff Notes: This log misfiled, then new copy submitted in 1966 and entered as CLAC 8602. Saved both under CLAC 8602.

**CLAC 8602**

**WATER WELL REPORT**

STATE OF OREGON

State Well No. 3/E-2TR/ <sup>26</sup>

State Permit No. \_\_\_\_\_

ORIGINAL

File Original and Duplicate with the STATE ENGINEER, SALEM, OREGON

**(1) OWNER:**

Name Fritz Danielson  
Address Aurora, Oregon

**CLAC 8602**  
~~009694~~

**(11) WELL TESTS:**

Drawdown is amount water level is lowered below static level

Was a pump test made?  Yes  No If yes, by whom? driller  
Yield: 150 gal./min. with 90ft. drawdown after 5 hrs.

Bailer test gal./min. with ft. drawdown after hrs.

Artesian flow g.p.m. Date

Temperature of water Was a chemical analysis made?  Yes  No

**(2) LOCATION OF WELL:**

County Clatsop Owner's number, if any—  
SE SE 1/4 Section 26, 27, 34, 35 T. 35 R. 1 W.M.

Bearing and distance from section or subdivision corner  
7.48 ft west & 375 ft  
West of Section 26, 27, 34, 35

**(12) WELL LOG:**

Diameter of well 8 inches.

Depth drilled 139ft 6in. Depth of completed well 139ft 6in.

Formation: Describe by color, character, size of material and structure, and show thickness of aquifers and the kind and nature of the material in each stratum penetrated, with at least one entry for each change of formation.

MATERIAL	FROM	TO
Surface	0	3
Grey sand	3	78
Red sand	78	122
Black sand	122	136
Gravel	136	136'6"

**TYPE OF WORK (check):**

Well  Deepening  Reconditioning  Abandon   
If abandonment, describe material and procedure in Item 11.

**(4) PROPOSED USE (check):**

Domestic  Industrial  Municipal   
Irrigation  Test Well  Other

**(5) TYPE OF WELL:**

Rotary  Driven   
Cable  Jetted   
Dug  Bored

**(6) CASING INSTALLED:**

Threaded  Welded

Diam. from 0 ft. to 139ft 6in Gage \_\_\_\_\_  
Diam. from \_\_\_\_\_ ft. to \_\_\_\_\_ ft. Gage \_\_\_\_\_  
Diam. from \_\_\_\_\_ ft. to \_\_\_\_\_ ft. Gage \_\_\_\_\_

**(7) PERFORATIONS:**

Perforated?  Yes  No

Type of perforator used \_\_\_\_\_

SIZE of perforations	in. by	in.
perforations from _____	ft. to _____	ft.
perforations from _____	ft. to _____	ft.
perforations from _____	ft. to _____	ft.
perforations from _____	ft. to _____	ft.

**(8) SCREENS:**

Well screen installed  Yes  No

Manufacturer's Name \_\_\_\_\_  
Model No. \_\_\_\_\_  
Diam. Slot size Set from \_\_\_\_\_ ft. to \_\_\_\_\_ ft.  
Diam. Slot size Set from \_\_\_\_\_ ft. to \_\_\_\_\_ ft.

**CONSTRUCTION:**

Well gravel packed?  Yes  No Size of gravel: \_\_\_\_\_  
Gravel placed from \_\_\_\_\_ ft. to \_\_\_\_\_ ft.  
Was a surface seal provided?  Yes  No To what depth? \_\_\_\_\_ ft.  
Material used in seal—  
Did any strata contain unusable water?  Yes  No  
Type of water? \_\_\_\_\_ Depth of strata \_\_\_\_\_  
Method of sealing strata off \_\_\_\_\_

**(10) WATER LEVELS:**

Static level \_\_\_\_\_ ft. below land surface Date \_\_\_\_\_  
Artesian pressure \_\_\_\_\_ lbs. per square inch Date \_\_\_\_\_

Log Accepted by:

[Signed] Fritz Danielson Date July 30, 1957.  
(Owner)

**(13) PUMP:**

Manufacturer's Name \_\_\_\_\_  
Type: \_\_\_\_\_ H.P. \_\_\_\_\_

**Well Driller's Statement:**

This well was drilled under my jurisdiction and this report is true to the best of my knowledge and belief.

NAME John Truman Miller  
(Person, firm, or corporation) (Type or print)

Address Rte 1 Box 259 Hubbard, Oregon

Driller's well number \_\_\_\_\_

[Signed] John Truman Miller  
(Well Driller)

License No. 39 Date July 30, 1957

RECEIVED  
AUG 7 1957  
STATE ENGINEER  
SALEM, OREGON

Work started July 20 1957 Completed July 30 1957

3 HP  
11/2/64

CLAC  
CLAC 8602

NOTICE TO WATER WELL CONTRACTOR  
The original and first copy  
of this report are to be  
filed with the  
STATE ENGINEER, SALEM 10, OREGON  
within 30 days from the date  
of well completion.

WATER WELL REPORT

08602 STATE OF OREGON  
(Please type or print)

RECEIVED  
State Well No. 3/16-26M

State Permit No.

(1) OWNER:

Name Fritz Danielson  
Address Aurora, Oregon

(2) LOCATION OF WELL:

County Clatsop Driller's well number  
NW 1/4 SW 1/4 Section 26 T. 35 R. 1W W.M.  
Bearing and distance from section or subdivision corner

(3) TYPE OF WORK (check):

Well  Deepening  Reconditioning  Abandon   
andonment, describe material and procedure in Item 12.

(4) PROPOSED USE (check):

Domestic  Industrial  Municipal   
Irrigation  Test Well  Other

(5) TYPE OF WELL:

Rotary  Driven   
Cable  Jetted   
Dug  Bored

(6) CASING INSTALLED:

Threaded  Welded   
8" Diam. from 0 ft. to 139'6" ft. Gage  
" Diam. from ft. to ft. Gage  
" Diam. from ft. to ft. Gage

(7) PERFORATIONS:

Perforated?  Yes  No  
Type of perforator used  
Size of perforations in. by in.  
perforations from ft. to ft.  
perforations from ft. to ft.  
perforations from ft. to ft.  
perforations from ft. to ft.  
perforations from ft. to ft.

(8) SCREENS:

Well screen installed  Yes  No  
Manufacturer's Name  
Model No.  
Slot size Set from ft. to ft.  
Diam. Slot size Set from ft. to ft.

(9) CONSTRUCTION:

Well seal—Material used in seal  
Depth of seal ft. Was a packer used?  
Diameter of well bore to bottom of seal in.  
Were any loose strata cemented off?  Yes  No Depth  
Was a drive shoe used?  Yes  No  
Was well gravel packed?  Yes  No Size of gravel:  
Gravel placed from ft. to ft.  
Did any strata contain unusable water?  Yes  No  
Type of water? Depth of strata  
Method of sealing strata off

(10) WATER LEVELS:

Static level ft. below land surface Date  
Artesian pressure lbs. per square inch Date

(11) WELL TESTS:

Drawdown is amount water level is lowered below static level  
Was a pump test made?  Yes  No If yes, by whom? driller  
Yield: 150 gal./min. with 90 ft. drawdown after 5 hrs.  
" " " "  
" " " "  
" " " "  
Baller test gal./min. with ft. drawdown after hrs.  
Artesian flow g.p.m. Date  
Temperature of water Was a chemical analysis made?  Yes  No

(12) WELL LOG:

Diameter of well below casing  
Depth drilled 139'6" ft. Depth of completed well 139'6" ft.  
Formation: Describe by color, character, size of material and structure, and show thickness of aquifers and the kind and nature of the material in each stratum penetrated, with at least one entry for each change of formation.

MATERIAL	FROM	TO
Surface	0	3
Gray sand	3	78
Red sand	78	122
Black sand	122	136
Gravel	136	139'6"

Application No. G-3682  
Permit No.

Work started July 20 19 57 Completed July 30 19 57  
Date well drilling machine moved off of well 19

(13) PUMP:

Manufacturer's Name  
Type: H.P.

Water Well Contractor's Certification:

This well was drilled under my jurisdiction and this report is true to the best of my knowledge and belief.

NAME John Truman Miller  
(Person, firm or corporation) (Type or print)

Address P.O. Box 42 Hubbard, Oregon

Drilling Machine Operator's License No.

[Signed] (Water Well Contractor)

Contractor's License No. Date, 19

STATE ENGINEER  
Salem, Oregon

**CLAC** **CLAC 8602**  
**Well Record**  
**08602**

STATE WELL NO. 3/1W-26M(1).  
COUNTY Clackamas  
APPLICATION NO. \_\_\_\_\_


OWNER: Fritz Danielson

**CLAC**  
MAILING ADDRESS: \_\_\_\_\_  
CITY AND STATE: \_\_\_\_\_

LOCATION OF WELL: Owner's No. \_\_\_\_\_

..... 1/4 ..... 1/4 Sec. ..... T. ..... N. ..... E.  
..... S., R. ..... W., W.M.

Bearing and distance from section or subdivision  
corner \_\_\_\_\_  
\_\_\_\_\_  
\_\_\_\_\_

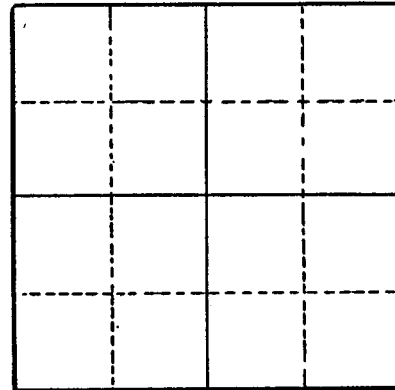

Section \_\_\_\_\_

Altitude at well 162

TYPE OF WELL: Drilled Date Constructed 1957

Depth drilled 139 1/2 Depth cased 139 1/2

CASING RECORD:

8 inch

FINISH:

Open bottom (casing unperforated)

AQUIFERS:

Gravel from 136 to 139 1/2

WATER LEVEL:

PUMPING EQUIPMENT: Type \_\_\_\_\_ H.P. \_\_\_\_\_  
Capacity \_\_\_\_\_ G.P.M.

WELL TESTS:

Drawdown \_\_\_\_\_ ft. after \_\_\_\_\_ hours \_\_\_\_\_ G.P.M.  
Drawdown \_\_\_\_\_ ft. after \_\_\_\_\_ hours \_\_\_\_\_ G.P.M.

USE OF WATER Domestic Temp. \_\_\_\_\_ °F. \_\_\_\_\_, 19\_\_\_\_  
SOURCE OF INFORMATION USGS

DRILLER or DIGGER \_\_\_\_\_

ADDITIONAL DATA:

Log X Water Level Measurements \_\_\_\_\_ Chemical Analysis \_\_\_\_\_ Aquifer Test \_\_\_\_\_

REMARKS:



# CLAC 8602



Oregon Water Resources Department  
725 Summer Street NE, Suite A  
Salem Oregon 97301  
(503) 986-0900  
www.oregon.gov/owrd

## Application for Well ID Number

RECEIVED

MAY 19 2020

OWRD

*Do not complete if the well already has a Well Identification Number.*

### I. OWNER INFORMATION

Current Owner Name (please print): Pat Davis and Lisa Hynes  
Mailing Address: 24877 NE Boones Ferry Rd  
City, State, Zip: Aurora, OR 97002  
Mail Well ID to:  SAME AS ABOVE  In Care Of (C/O)  
Name & Address: \_\_\_\_\_  
City, State, Zip: \_\_\_\_\_

### II. WELL LOCATION INFORMATION (Please fill out as completely as possible)

Township: 3 south (North / South) Range: 2 west (East / West) Section: 27 NW 1/4 of the SW 1/4  
Tax Lot (usually last 3-5 numbers of Tax Map #): 3503 County Clackamas  
GPS Coordinates: \_\_\_\_\_  
Street Address of Well, City: 24877 NE Boones Ferry Rd Aurora  
If the property had a different street address in the past: \_\_\_\_\_

### III. GENERAL WELL INFORMATION (Please fill out as completely as possible, AND attach copy of Well Report, if available)

Use of Well (domestic, irrigation, commercial, industrial, monitoring): Listed domestic  
Date Well Constructed (or property built): July 30, 1957 Total Well Depth: 139.5 feet Casing Diameter: 8 inch  
Owner at time the well was constructed (if known): Fritz Danielson Well Report # (if known): CLAC 8602  
Other Information: \_\_\_\_\_

SUBMITTED BY (please print): PATRICK DAVIS  
PHONE: 503 7069536 EMAIL &/or FAX: PDAVIS@TOOLSUPPLY.COM

Send application to: Oregon Water Resources Department 725 Summer St NE, Suite A, Salem, Oregon 97301; or fax to (503) 986-0902.  
Applications are processed in the order they are received, and Well ID Numbers are mailed within 4-5 business days.

For Official Use Only by the Oregon Water Resources Department:

Received Date:  
5-19-2020

Well Report Number:  
CLAC 8602

Well Identification #:  
L 138123