

STATE ENGINEER
Salem, Oregon

CLAC
08667

Well Record
CLAC

STATE WELL NO. 3/W-280
COUNTY Clackamas
APPLICATION NO. GR-3929

OWNER: A. L. Pugh

MAILING ADDRESS: Route 1, Box 181 F

LOCATION OF WELL: Owner's No.

CITY AND STATE: Brooks, Oregon

SW 1/4 SE 1/4 Sec. 28 T. 3 S., R. 1 W., W.M.

Bearing and distance from section or subdivision corner N. 79° W. 2545 ft. from SE Cor. Sec. 28

		X	

Section 28

Altitude at well

TYPE OF WELL: Drilled Date Constructed Apr., 1952

Depth drilled 70 ft. Depth cased 70 ft.

CASING RECORD:

10 inch casing set to 70 ft.

FINISH:

4 - 1" x 2" perforations from 40 to 70 feet

AQUIFERS:

WATER LEVEL:

flowing

PUMPING EQUIPMENT: Type Pacific centrifugal H.P. 10
Capacity 300 G.P.M.

WELL TESTS:

Drawdown 40 ft. after 400 hours G.P.M.
Drawdown ft. after hours G.P.M.


USE OF WATER Irrigation Temp. °F. 19
SOURCE OF INFORMATION Well Registration Statement Cert. # GR-3564
DRILLER or DIGGER Wymore Drillers

ADDITIONAL DATA:

Log Water Level Measurements Chemical Analysis Aquifer Test

REMARKS:

STATE ENGINEER
Salem, Oregon

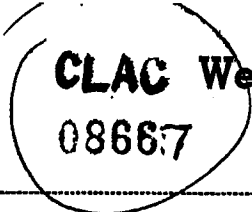

STATE WELL NO. 3/1W-28Q(1)
COUNTY Clackamas
APPLICATION NO.

OWNER: A. L. Pugh


MAILING ADDRESS:

LOCATION OF WELL: Owner's No.

CITY AND STATE:

..... 1/4 1/4 Sec. T. N. S., R. E. W., W.M.

Bearing and distance from section or subdivision corner

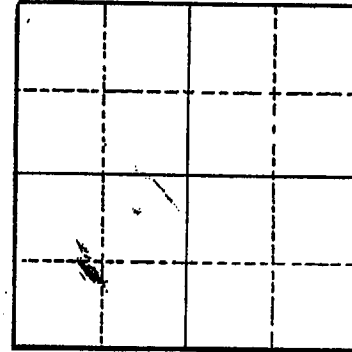

Section

Altitude at well 95

TYPE OF WELL: Drilled Date Constructed 1952

Depth drilled 70 Depth cased 70

CASING RECORD:

10 inch

FINISH:

Casing perforated 40 to 70

AQUIFERS:

WATER LEVEL:

Flowing well

PUMPING EQUIPMENT: Type Centrifugal H.P. 7 1/2
Capacity G.P.M.

WELL TESTS:

Drawdown ft. after hours G.P.M.

Drawdown ft. after hours G.P.M.

USE OF WATER Irrigation 25 acres Temp. °F. 19

SOURCE OF INFORMATION USGS

DRILLER or DIGGER

ADDITIONAL DATA:

Log Water Level Measurements Chemical Analysis Aquifer Test

REMARKS: