

STATE ENGINEER  
Salem, Oregon

**CLAC Well Record**  
**08668**

STATE WELL NO. 3/1W-28Q(1)  
COUNTY Clackamas  
CLAC APPLICATION NO.

OWNER: A. L. Pugh


MAILING ADDRESS:

LOCATION OF WELL: Owner's No.

CITY AND STATE:

..... 1/4 ..... 1/4 Sec. ..... T. ..... N. S., R. ..... E. W., W.M.

Bearing and distance from section or subdivision corner

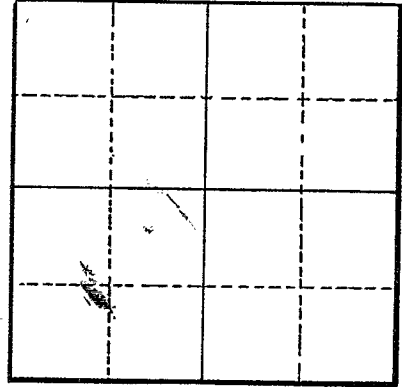

Section

Altitude at well 95

TYPE OF WELL: Drilled Date Constructed 1952

Depth drilled 70 Depth cased 70

CASING RECORD:  
10 inch

FINISH:

Casing perforated 40 to 70

AQUIFERS:

WATER LEVEL:

Flowing well

PUMPING EQUIPMENT: Type Centrifugal

H.P. 7 1/2

Capacity G.P.M.

WELL TESTS:

Drawdown ft. after hours G.P.M.

Drawdown ft. after hours G.P.M.

USE OF WATER Irrigation 25 acres

Temp. °F. 19

SOURCE OF INFORMATION USGS

DRILLER or DIGGER

ADDITIONAL DATA:

Log Water Level Measurements Chemical Analysis Aquifer Test

REMARKS: