

STATE ENGINEER
Salem, Oregon

CLAC
868

Well Record

00886

STATE WELL NO. 1/3-36G
COUNTY Clackamas
APPLICATION NO. GR-3007

OWNER: George F. and Grace Lane


MAILING ADDRESS: Route 2, Box 248

LOCATION OF WELL: Owner's No.

CITY AND STATE: Boring, Oregon

SW 1/4 NE 1/4 Sec. 36 T. 1 N. S., R. 3 E. W., W.M.

Bearing and distance from section or subdivision corner S. 55° W. N.E. corner Section 36; 2600'

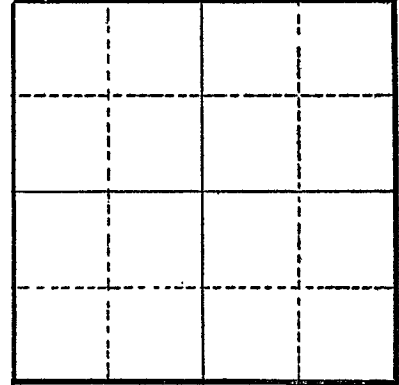

Section

Altitude at well

TYPE OF WELL: drilled Date Constructed 1947

Depth drilled 117 1/2 Depth cased 79

CASING RECORD:

6 inch

FINISH:

AQUIFERS:

WATER LEVEL:

50 feet

PUMPING EQUIPMENT: Type Demming stroke workhead H.P. 1 1/2
Capacity 10 G.P.M.

WELL TESTS:

Drawdown ft. after hours G.P.M.
Drawdown ft. after hours G.P.M.

USE OF WATER Irrigation Temp. °F. 19

SOURCE OF INFORMATION GR-2816

DRILLER or DIGGER Haakon Bottner, 11544 N.E. Glisan St., Portland

ADDITIONAL DATA:

Log Water Level Measurements Chemical Analysis Aquifer Test

REMARKS: