

STATE ENGINEER
Salem, Oregon

Well Record

STATE WELL NO. 3/IW-29G
COUNTY Clackamas
APPLICATION NO. GR-3809

8686 CLAC

OWNER: John M. & Helen M. Selander
dba Three Creeks

MAILING ADDRESS: Route 2, Box 244


LOCATION OF WELL: Owner's No.

CITY AND STATE: Sherwood, Oregon

SW 1/4 NE 1/4 Sec. 29 T. 3 S., R. 1 W., W.M.

Bearing and distance from section or subdivision

corner 2000' S. of N. Line of Sec. 29, & 2400' E.
of W. Line of Sec. 29

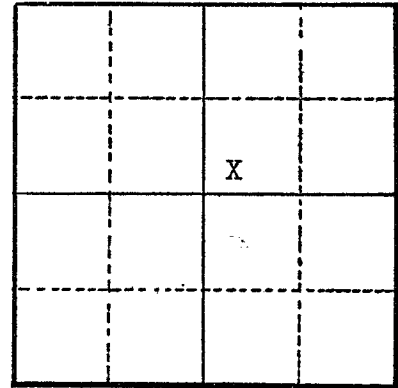

Section 29

Altitude at well

TYPE OF WELL: Drilled Date Constructed 1939

Depth drilled 89 feet Depth cased 89 feet

CASING RECORD:

6 inch casing set to 89 feet

FINISH:

AQUIFERS:

WATER LEVEL:

40 feet below surface

PUMPING EQUIPMENT: Type Advance centrifugal, model 1 1/2 V H.P. 1 1/2
Capacity 33 G.P.M.

WELL TESTS:

Drawdown 4 ft. after 33 hours G.P.M.

Drawdown ft. after hours G.P.M.

USE OF WATER Dairy Temp. °F., 19

SOURCE OF INFORMATION Well Registration Statement

DRILLER or DIGGER

ADDITIONAL DATA:

Log Water Level Measurements Chemical Analysis Aquifer Test

REMARKS:

3471