

STATE ENGINEER
Salem, Oregon

CLAC
869

Well Record

00869


STATE WELL NO. 1/3E-36G
COUNTY Clackamas
APPLICATION NO. GR-3251

OWNER: Albert Funkner MAILING ADDRESS: Route 2, Box 238

LOCATION OF WELL: Owner's No. CITY AND STATE: Boring, Oregon

SW 1/4 NE 1/4 Sec. 36 T. 1 S., R. 3 W., W.M.

Bearing and distance from section or subdivision corner 1600' NW from the SE Corner of the NE 1/4

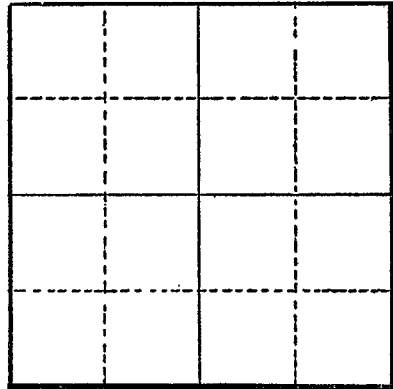

Section

Altitude at well

TYPE OF WELL: drilled Date Constructed 1946

Depth drilled 150 Depth cased

CASING RECORD:

8 inch

FINISH:

AQUIFERS:

WATER LEVEL:

60 feet

PUMPING EQUIPMENT: Type Gentry-Jet H.P. 1 1/2
Capacity 20 G.P.M.

WELL TESTS:

Drawdown ft. after hours pumping 100 G.P.M.

Drawdown ft. after hours G.P.M.

USE OF WATER Irrigation Temp. °F., 19

SOURCE OF INFORMATION GR-3025

DRILLER or DIGGER H. Bottner, 11544 NE Glison, Portland, Oregon

ADDITIONAL DATA:

Log Water Level Measurements Chemical Analysis Aquifer Test

REMARKS: