

STATE ENGINEER
Salem, Oregon

CLAC
870 00870

Well Record

STATE WELL NO. 1/3-36H
COUNTY CLACKAMAS
APPLICATION NO. GR-2738


OWNER: Milo A. Nelson & Margaret Ann Nelson

MAILING ADDRESS: Rt. 2, Box 234

LOCATION OF WELL: Owner's No.

CITY AND STATE: Boring, Oregon

SE 1/4 NE 1/4 Sec. 36 T. 1 N S, R. 3 E W, W.M.

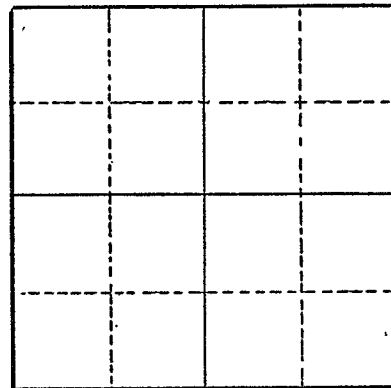

Bearing and distance from section or subdivision corner S. 30° W. of NE cor. Sec. 36 Approx. 1800'

Altitude at well

TYPE OF WELL: drilled Date Constructed 1955

Depth drilled 190 Depth cased 190

Section

CASING RECORD:

6-inch

FINISH:

4 slot per ft. from 100 to 190
3/16" x 2 1/2" mills perforator

AQUIFERS:

Clay, gravel

WATER LEVEL:

75-feet

PUMPING EQUIPMENT: Type Lineshift Turbine H.P. 60
Capacity 5 G.P.M.

WELL TESTS:

Drawdown 50 ft. after hours Pumping 100 G.P.M.
Drawdown 35 ft. after hours Pumping 60 G.P.M.

USE OF WATER irrigation Temp. °F. 19

SOURCE OF INFORMATION GR-2590

DRILLER or DIGGER A. O. Olsen, Gresham, Oregon

ADDITIONAL DATA:

Log Water Level Measurements Chemical Analysis Aquifer Test

REMARKS:

Red clay 1 70
Cemented gravel 70 190
Water bearing cement 100 190