

STATE ENGINEER
Salem, Oregon

Well Record

STATE WELL NO. 1/3 - 36K
COUNTY CLACKAMAS
APPLICATION NO. GR-2737

CLAC
00872

OWNER: Carlos W. Anthony


MAILING ADDRESS: Rt. 2, Box 296

LOCATION OF WELL: Owner's No. _____

CITY AND STATE: Boring, Oregon

NW 1/4 SE 1/4 Sec. 36 T. 1 S., R. 3 W., W.M.

Bearing and distance from section or subdivision
corner 2280' W. and 1600' N.

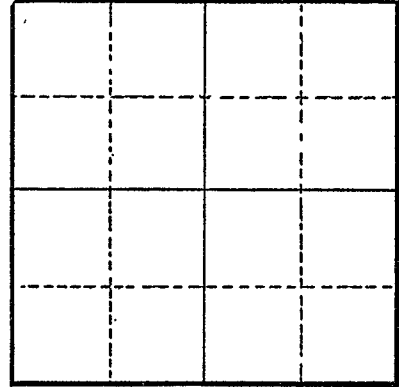

Section _____

Altitude at well _____

TYPE OF WELL: Drilled Date Constructed 1953

Depth drilled 93 Depth cased 93

CASING RECORD:

6-inch

FINISH:

AQUIFERS:

Clay and gravel

WATER LEVEL:

50-feet

PUMPING EQUIPMENT: Type Pacific Jet H.P. 1 1/2
Capacity 12 G.P.M.

WELL TESTS:

Drawdown None ft. after _____ hours Pumping 33 G.P.M.
Drawdown 20 ft. after _____ hours Pumping 75 G.P.M.

USE OF WATER Irrigation Temp. _____ °F., 19.

SOURCE OF INFORMATION GR-2182

DRILLER or DIGGER J. L. Klundt, 12612 S.E. Vernie, Milwaukie, Oregon

ADDITIONAL DATA:

Log Water Level Measurements _____ Chemical Analysis _____ Aquifer Test _____

REMARKS:

Clay Dry Surface 35 to 40
Gravel Water bearing 40 93