

STATE ENGINEER
Salem, Oregon

08775 CLAG

Well Record

STATE WELL NO. 3/1W-35D(1)
COUNTY Clackamas
APPLICATION NO. GR-554

OWNER: Donald D. DuRette


MAILING ADDRESS: Route 2

LOCATION OF WELL: Owner's No.

CITY AND STATE: Aurora, Oregon

NW 1/4 NW 1/4 Sec. 35 T. 3 N. S., R. 1 E. W., W.M.

Bearing and distance from section or subdivision corner 70' S. & 906' E. from NW corner, Sec. 35

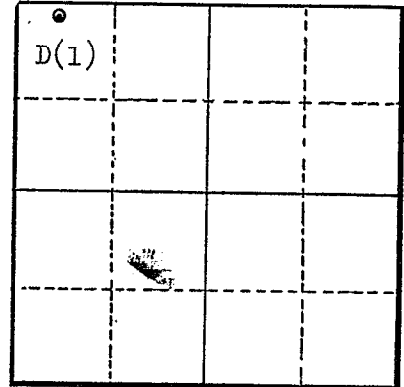

Altitude at well 185'

TYPE OF WELL: Drilled Date Constructed 9/10/51

Depth drilled 133 Depth cased Section 35

CASING RECORD:

10-inch

FINISH:

AQUIFERS:

WATER LEVEL:

60 feet

PUMPING EQUIPMENT: Type Peerless turbine H.P. 15
Capacity 300 G.P.M.

WELL TESTS:

Drawdown	105	ft. after	hours	500	G.P.M.
Drawdown	75	ft. after	hours	250	G.P.M.

USE OF WATER Irrigation 30 acres Temp. °F. , 19

SOURCE OF INFORMATION GR-554

DRILLER or DIGGER Wymore, Salem, Oregon

ADDITIONAL DATA: Log Water Level Measurements Chemical Analysis Aquifer Test

REMARKS: