

STATE ENGINEER  
Salem, Oregon

# Well Record

STATE WELL NO3/1W-35H(1)  
COUNTY Clackamas  
APPLICATION NO.

0: 8781


CLAC

OWNER: J. E. Langdon MAILING ADDRESS:

LOCATION OF WELL: Owner's No. CITY AND STATE:

1/4 1/4 Sec. T. N. S, R. E. W., W.M.

Bearing and distance from section or subdivision corner

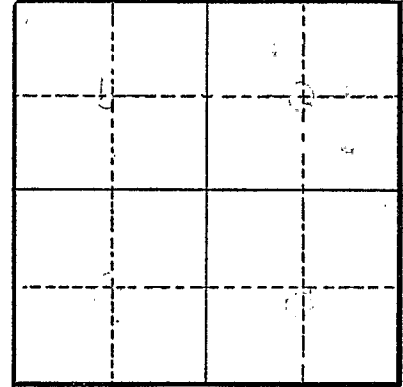

Section

Altitude at well 185

TYPE OF WELL: Drilled Date Constructed 1951

Depth drilled 143 Depth cased

CASING RECORD:

12 inch

FINISH:

AQUIFERS:

Gravel

WATER LEVEL:

58.11 feet below land surface on February 29, 1960

PUMPING EQUIPMENT: Type Turbine H.P. 20  
Capacity G.P.M.

WELL TESTS:

Drawdown ft. after hours G.P.M.  
Drawdown ft. after hours G.P.M.

USE OF WATER Irrigation Temp. °F. 19

SOURCE OF INFORMATION USGS

DRILLER or DIGGER

ADDITIONAL DATA:

Log Water Level Measurements Chemical Analysis Aquifer Test

REMARKS:

Not used in 1959-60.