

STATE ENGINEER  
Salem, Oregon

*Lo-Dan Staller*

CLAC  
0:8784

Well Record

Pg 1 of 4

STATE WELL NO. 3/1W-35N(1)  
COUNTY Clackamas  
APPLICATION NO.

OWNER: Earl Barber

MAILING ADDRESS:

LOCATION OF WELL: Owner's No.

CITY AND STATE:

..... 1/4 ..... 1/4 Sec. .... T. .... N. E. S., R. .... W., W.M.

Bearing and distance from section or subdivision corner


Altitude at well 190

TYPE OF WELL: Drilled.. Date Constructed 1950

Depth drilled 180 Depth cased 170

Section

CASING RECORD:

10 inch

FINISH:

Casing perforated 153-176

AQUIFERS:

Sand and gravel from 142 to 176

WATER LEVEL:

33 feet below land surface, September, 1950

PUMPING EQUIPMENT: Type Turbine H.P. 30  
Capacity G.P.M.

WELL TESTS:

Drawdown ..... ft. after ..... hours ..... G.P.M.

Drawdown ..... ft. after ..... hours ..... G.P.M.

USE OF WATER Irrigation--40 acres Temp. °F. 19

SOURCE OF INFORMATION USGS

DRILLER or DIGGER

ADDITIONAL DATA:

Log  Water Level Measurements ..... Chemical Analysis ..... Aquifer Test .....

REMARKS:





STATE ENGINEER  
Salem, Oregon

20 Dan Stoller  
CLAC  
0:8784

Well Record

STATE WELL NO. 3/1W - 35N  
COUNTY CLACKAMAS  
APPLICATION NO. GR-1599

OWNER: Earl Barber


MAILING ADDRESS: Rt. 2, Box 135

LOCATION OF WELL: Owner's No.

CITY AND STATE: Aurora, Oregon

1/4 1/4 Sec. 35 T. 3 S. R. 1 E. W.M.

Bearing and distance from section or subdivision corner 700' E. and 1120' N. from SW corner Sec. 35

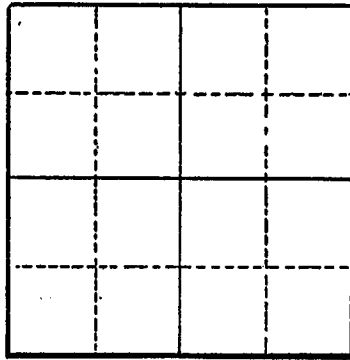

Altitude at well

TYPE OF WELL: Drilled Date Constructed 1950

Depth drilled 180 Depth cased 170

Section

CASING RECORD:

10-inch

FINISH:

Perforations from 153 to 176

AQUIFERS:

Clay

WATER LEVEL:

33-feet

PUMPING EQUIPMENT: Type Peerless Turbine H.P. 30  
Capacity 325 G.P.M.

WELL TESTS:

Drawdown 135 ft. after hours Pumping 325 G.P.M.  
Drawdown ft. after hours G.P.M.

USE OF WATER Irrigation Temp. °F. 19

SOURCE OF INFORMATION GR-2172

DRILLER or DIGGER

ADDITIONAL DATA:

Log  Water Level Measurements Chemical Analysis Aquifer Test

REMARKS: