

STATE ENGINEER
Salem, Oregon

20 Dan Stoller
CLAC
0:8735

Well Record

STATE WELL NO. 3/IW - 35N
COUNTY CLACKAMAS
APPLICATION NO. GR 1599

OWNER: Earl Barber


MAILING ADDRESS: Rt. 2, Box 135

LOCATION OF WELL: Owner's No.

CITY AND STATE: Aurora, Oregon

..... 1/4 1/4 Sec. 35 T. 3 N. S, R. 1 E. W., W.M.

Bearing and distance from section or subdivision corner 700' E. and 1120' N. from SW corner Sec. 35

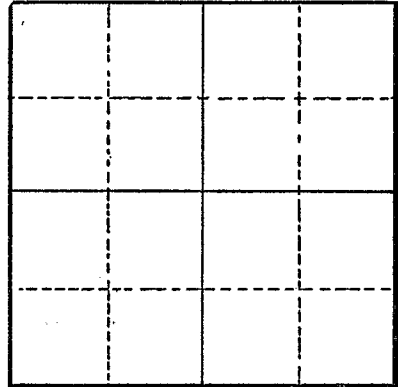

Section

Altitude at well

TYPE OF WELL: Drilled Date Constructed 1950

Depth drilled 180 Depth cased 170

CASING RECORD:

10-inch

FINISH:

Perforations from 153 to 176

AQUIFERS:

Clay

WATER LEVEL:

33-feet

PUMPING EQUIPMENT: Type Peerless Turbine H.P. 30
Capacity 325 G.P.M.

WELL TESTS:

Drawdown 135 ft. after hours Pumping 325 G.P.M.
Drawdown ft. after hours G.P.M.

USE OF WATER Irrigation Temp. °F., 19

SOURCE OF INFORMATION GR-2172

DRILLER or DIGGER

ADDITIONAL DATA:

Log Water Level Measurements Chemical Analysis Aquifer Test

REMARKS: