

STATE ENGINEER  
Salem, Oregon


**Well Record**  
8803CLAC

STATE WELL NO. 3/1W-36D  
COUNTY Clackamas  
APPLICATION NO. GR-3054

OWNER: William F. Schaad, Virginia J. Schaad and Stanley D. Schaad MAILING ADDRESS: \_\_\_\_\_

LOCATION OF WELL: Owner's No. \_\_\_\_\_ CITY AND STATE: Aurora, Oregon

NW 1/4 NW 1/4 Sec. 36 T. 3 S., R. 1 W., W.M.  
Bearing and distance from section or subdivision corner 477 feet East and 600 feet South from the NW Corner, Section 36.

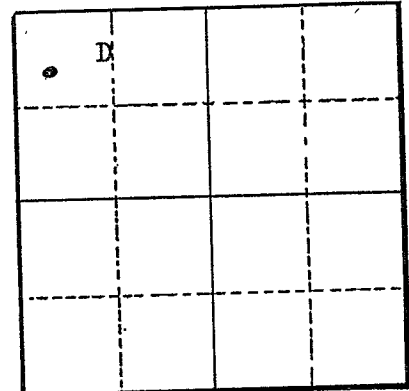

Altitude at well 150 feet

TYPE OF WELL: Drilled Date Constructed \_\_\_\_\_

Depth drilled 130 feet Depth cased 130 feet

Section 36

CASING RECORD:

6-inch casing set from top to 130 feet

FINISH:

AQUIFERS:

WATER LEVEL:

80 feet

PUMPING EQUIPMENT: Type Peerless Deep Well Turbine 4" H.P. \_\_\_\_\_  
Capacity 250 G.P.M.

WELL TESTS:

Drawdown \_\_\_\_\_ ft. after \_\_\_\_\_ hours \_\_\_\_\_ G.P.M.  
Drawdown \_\_\_\_\_ ft. after \_\_\_\_\_ hours \_\_\_\_\_ G.P.M.

USE OF WATER Irrigation Temp. \_\_\_\_\_ °F. \_\_\_\_\_, 19\_\_\_\_

SOURCE OF INFORMATION GR-4050

DRILLER or DIGGER J. T. Miller

ADDITIONAL DATA:

Log (NA) Water Level Measurements \_\_\_\_\_ Chemical Analysis \_\_\_\_\_ Aquifer Test \_\_\_\_\_

REMARKS: