

STATE ENGINEER
Salem, Oregon

Well Record

STATE WELL NO. 3/1W - 36D(2)
COUNTY CLACKAMAS
APPLICATION NO. GR-2282

8805
CLAG

OWNER: Gilbert T. Schaad


MAILING ADDRESS: Route 2

LOCATION OF WELL: Owner's No. _____

CITY AND STATE: Aurora, Oregon

NW 1/4 NW 1/4 Sec. 36 T. 3 N. S., R. 1 E. W., W.M.

Bearing and distance from section or subdivision corner 18.5 Chains S. and 6 Chains E. from the NW corner of Sec. 36.

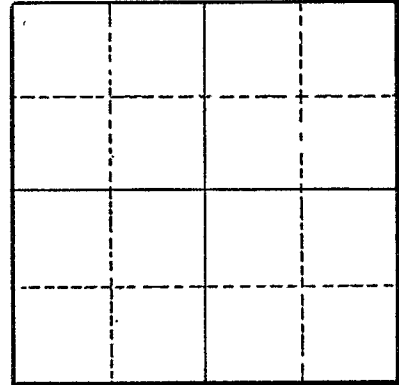

Altitude at well 168

TYPE OF WELL: Drilled Date Constructed 1952

Depth drilled 121 Depth cased 115

Section _____

CASING RECORD:

8-inch

FINISH:

AQUIFERS:

Sand and gravel

WATER LEVEL:

45-Feet (4, 52)

PUMPING EQUIPMENT: Type Pomona Turbine H.P. 7 1/4

Capacity 130 G.P.M.

WELL TESTS:

Drawdown 40 ft. after _____ hours Pumping 300 G.P.M.

Drawdown 10 ft. after _____ hours Pumping 100 G.P.M.

USE OF WATER Irrigation Temp. _____ °F., 19 _____

SOURCE OF INFORMATION GR-2175

DRILLER or DIGGER _____

ADDITIONAL DATA:

Log X Water Level Measurements _____ Chemical Analysis _____ Aquifer Test _____

REMARKS:

0-23'	Surface	23	23		
23-27'	Surface, sand, and small gravel	4	27		
27-48'	Gray Clay	21	48		
48-113'	Broken red sand and gravel muddy	65	113		
115-119'	Coarse black sand and gravel	4	119		