

STATE ENGINEER
Salem, Oregon

CLAC Well Record
008810

STATE WELL NO. 3/1W-36M
COUNTY Clackamas
APPLICATION NO. GR-3102

OWNER: Henry W. B. Colvin


MAILING ADDRESS: Route 2, Box 287

LOCATION OF WELL: Owner's No.

CITY AND STATE: Aurora, Oregon

NW $\frac{1}{4}$ SW $\frac{1}{4}$ Sec. 36 T. 3 N. S. R. 1 E. W. M.

Bearing and distance from section or subdivision
corner 1584' N. & 866' E.

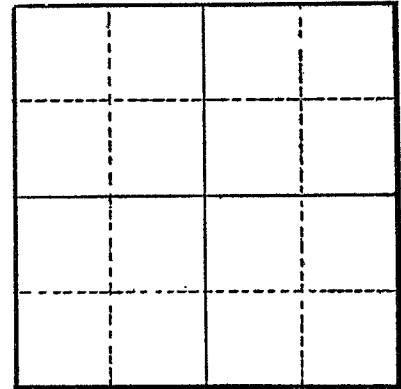

Section

Altitude at well

TYPE OF WELL: Drilled Date Constructed 1950

Depth drilled 162 feet Depth cased 150 feet

CASING RECORD:

10-inch

FINISH:

AQUIFERS:

Surface, clay, sand

WATER LEVEL:

31 feet

PUMPING EQUIPMENT: Type Peerless turbine H.P. 30
Capacity 300 G.P.M.

WELL TESTS:
Drawdown 95 ft. after hours Pumping 500 G.P.M.
Drawdown ft. after hours G.P.M.

USE OF WATER Irrigation Temp. °F. 19

SOURCE OF INFORMATION GR-2910

DRILLER or DIGGER

ADDITIONAL DATA:

Log ☒ Water Level Measurements Chemical Analysis Aquifer Test

REMARKS:

State Well No. 3/1W-36M
County Clackamas
~~Application No.~~ GR-3102

Owner: Henry W. B. Colvin Owner's No. _____

Driller: _____ Date Drilled: 1950

[illegible]