

STATE ENGINEER
Salem, Oregon

CLAC
008858

Well Record

STATE WELL NO. 3/1-3A
COUNTY Clackamas
APPLICATION NO. GR-4193

OWNER: DAN LEROY DAVIS


MAILING ADDRESS: Route 1, Box 477

LOCATION OF WELL: Owner's No. _____

CITY AND STATE: Oregon City, Oregon

NE 1/4 NE 1/4 Sec. 3 T. 3 S., R. 1 E. W.M.

Bearing and distance from section or subdivision
corner 1100 feet South and 1200 feet West from
the NE Corner, Section 3

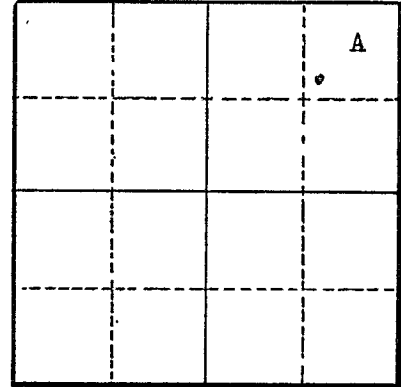

Section 3

Altitude at well _____

TYPE OF WELL: Drilled Date Constructed 6-1-52

Depth drilled 108 feet Depth cased 23 feet

CASING RECORD:

6-inch steel casing set from 0 to 23 feet

FINISH:

AQUIFERS:

rock and clay

WATER LEVEL:

25 feet

PUMPING EQUIPMENT: Type Fairbanks Morse Jet H.P. _____
Capacity 40 G.P.M.

WELL TESTS:

Drawdown 48 ft. after _____ hours 75 G.P.M.

Drawdown _____ ft. after _____ hours _____ G.P.M.

USE OF WATER Irrigation Temp. _____ °F. _____, 19____

SOURCE OF INFORMATION GR-4042

DRILLER or DIGGER Wm. J. Stennett

ADDITIONAL DATA:

Log X Water Level Measurements _____ Chemical Analysis _____ Aquifer Test _____

REMARKS:

0 feet 6 red soil
6 feet 22 clay
22 feet 42 gray rock
42 feet 90 gray clay

water comes out of thin layer of sand in clay beds at 90 feet