

STATE ENGINEER  
Salem, Oregon

# Well Record

STATE WELL NO. 1/4-25P  
COUNTY CLACKAMAS  
APPLICATION NO. GR-2131

OWNER: Amy Irene Geertz

MAILING  
ADDRESS:

Rt. 1, Box 257

LOCATION OF WELL: Owner's No.

CITY AND  
STATE:

Boring, Oregon

SE 1/4 SW 1/4 Sec. 25 T. 1 S., R. 4 E. W.M.


Bearing and distance from section or subdivision  
corner 930' N & 440' W from S corner Sec. 25

Altitude at well

TYPE OF WELL: NA Date Constructed 1952

Depth drilled NA Depth cased

CASING RECORD:

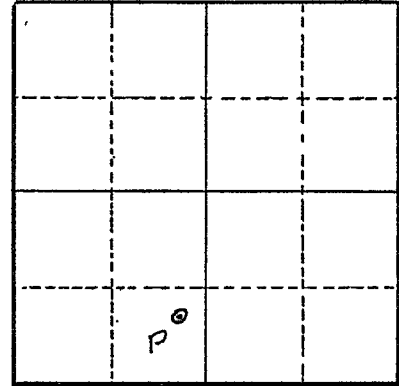

Section 25

FINISH:

AQUIFERS:

WATER LEVEL:

NA

PUMPING EQUIPMENT: Type Gould Centrifugal Pump H.P.  
Capacity 5 to 150 G.P.M.

WELL TESTS:

Drawdown ft. after hours G.P.M.

Drawdown ft. after hours G.P.M.

USE OF WATER Irrigation Temp. °F., 19

SOURCE OF INFORMATION Gr-3849

DRILLER or DIGGER

ADDITIONAL DATA:

Log NA Water Level Measurements Chemical Analysis Aquifer Test

REMARKS: