

STATE ENGINEER
Salem, Oregon

CLAC

00893

Well Record

STATE WELL NO. 1/4-25P1
COUNTY MULTNOMAH
APPLICATION NO.

OWNER: A. I. Geetz

MAILING
ADDRESS:

LOCATION OF WELL: Owner's No.

CITY AND
STATE:

1/4 1/4 Sec. T. N. S., R. E. W., W.M.


Bearing and distance from section or subdivision

corner

Altitude at well 585

TYPE OF WELL: Dug Date Constructed

Depth drilled 10 Depth cased 10

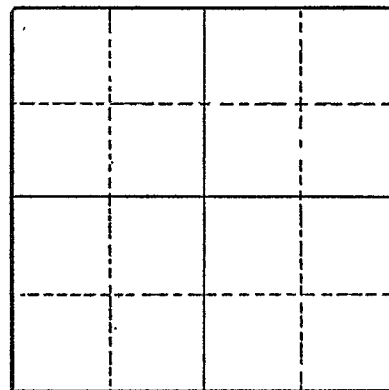

Section

CASING RECORD:

108 inch

FINISH:

AQUIFERS:

Cemented gravel, Younger terrace deposits

WATER LEVEL:

4.9 feet below land surface on April 4, 1955

PUMPING EQUIPMENT: Type Centrifugal H.P.
Capacity 150 G.P.M.

WELL TESTS:

Drawdown ft. after hours G.P.M.

Drawdown ft. after hours G.P.M.

USE OF WATER Irrigation Temp. °F., 19

SOURCE OF INFORMATION USGS

DRILLER or DIGGER

ADDITIONAL DATA:

Log Water Level Measurements Chemical Analysis Aquifer Test

REMARKS:

Hardness 14 ppm, Chloride 3 ppm.

Specific conductance in micromhos at 25° C.-52.