

STATE ENGINEER
Salem, Oregon

CLACKAMAS Well Record
009010

STATE WELL NO. 3/1-6A
COUNTY CLACKAMAS
APPLICATION NO. GR-3382

OWNER: Haven Nutting


MAILING ADDRESS: Rt 1 Box 156A

LOCATION OF WELL: Owner's No.

CITY AND STATE: Sherwood, Oregon

NE 1/4 NE 1/4 Sec. 6 T. 3 S., R. 1 E. W.M.

Bearing and distance from section or subdivision corner 1150' S & 800' W from NE cor of Sec 6

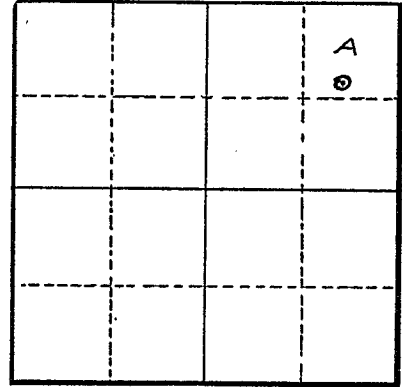

Section 6

Altitude at well

TYPE OF WELL: Drilled Date Constructed 1942

Depth drilled 410' Depth cased 410'

CASING RECORD:

6-inch

FINISH:

AQUIFERS: soil & cemented gravel
solid rock

WATER LEVEL: 365'

PUMPING EQUIPMENT: Type Goulds H.P. 5
Capacity 12 G.P.M.

WELL TESTS:
Drawdown ft. after hours 11 1/2 G.P.M.
Drawdown ft. after hours G.P.M.

USE OF WATER Irrigation Temp. °F. 19

SOURCE OF INFORMATION GR-3964

DRILLER or DIGGER Joe Plant

ADDITIONAL DATA:

Log ~~X~~ Water Level Measurements Chemical Analysis Aquifer Test

REMARKS:

soil & cemented gravel 30'
solid rock 410'

For Official Use Only:

Received Date:

4-2-98

County Well Log ID #

CLAC 9010

Well Identification Tag #

24600

WELL IDENTIFICATION APPLICATION FORM**BUYER/CURRENT WELL OWNER:**

Name:

Betsy Unger

Mailing Address:

24121 SW Newland Rd.

City:

Wilsonville

State:

OR

Zip:

97070

Phone:

()

WELL LOCATION:

County:


Owner's Well Number:

Township:

3

N or (S)

Range:

10

E or W, Section:

6

NE 1/4

NE 1/4

Tax Lot Number:

Type of Well:

water supply

monitoring

Street Address of Well (if different from above):

Same

WELL INFORMATION: (do not complete remainder of application if well log is available)

Start Card Number:

Approx. Construction Date:

Well Constructor:

Name of Owner at Time of Construction:

Well Depth (in feet):

Static Water Level (in feet):

Diameter of Exposed Well Casing (in inches):

Does this well have a formal water right associated with it? Yes:

No:

If Yes: Application #:

Permit #:

Certificate #:

Please Return Completed Form to:

Lisa Juul

Well Identification Program

Oregon Water Resources Department

158 12th Street NE

Salem, OR 97310