

STATE ENGINEER  
Salem, Oregon

**CLAC**  
**009067**  
**Well Record**

STATE WELL NO. 3/1-7 A  
COUNTY CLACKAMAS  
APPLICATION NO. GR-1904

OWNER: G. T. or Eva Chapman


MAILING ADDRESS: RT 1 Box 293

LOCATION OF WELL: Owner's No. \_\_\_\_\_

CITY AND STATE: Oregon

NE 1/4 NE 1/4 Sec. 7 T. 3 S., R. 1 E., W.M.

Bearing and distance from section or subdivision  
corner 900' W 50' S

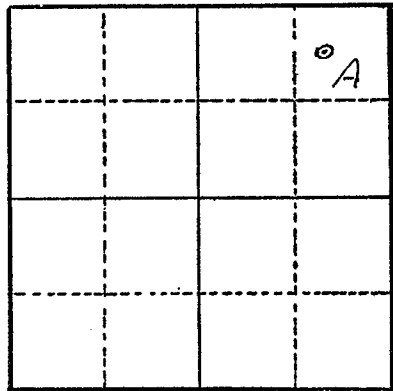

Section 7

Altitude at well \_\_\_\_\_

TYPE OF WELL: Drilled Date Constructed 1945

Depth drilled 80' Depth cased \_\_\_\_\_

CASING RECORD:

FINISH:

AQUIFERS:

Dirt, Solid rock

WATER LEVEL:

40'

PUMPING EQUIPMENT: Type Juczzi

H.P. 2

Capacity 30 G.P.M.

WELL TESTS:

Drawdown 20 ft. after \_\_\_\_\_ hours 30 G.P.M.

Drawdown \_\_\_\_\_ ft. after \_\_\_\_\_ hours \_\_\_\_\_ G.P.M.

USE OF WATER Irrigation Temp. \_\_\_\_\_ °F., 19. \_\_\_\_\_

SOURCE OF INFORMATION GR-3881

DRILLER or DIGGER \_\_\_\_\_

ADDITIONAL DATA:

Log  Water Level Measurements \_\_\_\_\_ Chemical Analysis \_\_\_\_\_ Aquifer Test \_\_\_\_\_

REMARKS:

Dirt 6' 72& solid rock.