

STATE ENGINEER
Salem, Oregon

CLAC Well Record
009072

STATE WELL NO. 3/1-7E(1)
COUNTY Clackamas
APPLICATION NO.


OWNER: Harry F. Lane

MAILING ADDRESS:

LOCATION OF WELL: Owner's No.

CITY AND STATE:

SW 1/4 NW 1/4 Sec. 7 T. 3 S, R. 1 E, W.M.

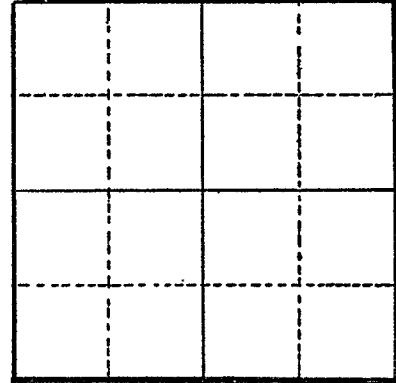

Bearing and distance from section or subdivision corner

Section

Altitude at well 230 ft.

TYPE OF WELL: drilled Date Constructed

Depth drilled 235 ft. Depth cased 118 ft.

CASING RECORD: 6 inch

FINISH:

AQUIFERS: Basalt from 118 to 235 ft.

WATER LEVEL: 62 ft. below land surface

PUMPING EQUIPMENT: Type turbine H.P.
Capacity G.P.M.

WELL TESTS:
Drawdown ft. after hours G.P.M.
Drawdown ft. after hours G.P.M.

USE OF WATER domestic & irrigation Temp. °F., 19.

SOURCE OF INFORMATION USGS

DRILLER or DIGGER

ADDITIONAL DATA:
Log Water Level Measurements Chemical Analysis Aquifer Test

REMARKS: Used for irrigating 25 acres; reported to have yielded 230 gpm with drawdown of 120 ft. after 10 days of pumping.