


STATE ENGINEER
Salem, Oregon

Well Record

STATE WELL NO. 3/1-7F
COUNTY Clackamas
APPLICATION NO. GR-577

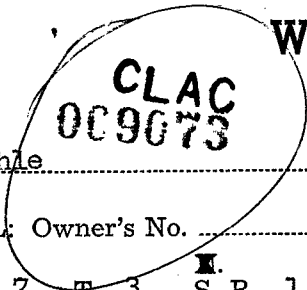


OWNER: Ernest Kahle MAILING ADDRESS: Rt. 1, Box 362

LOCATION OF WELL: Owner's No. _____ CITY AND STATE: Sherwood, Oregon

SE ¼ NW ¼ Sec. 7 T. 3 S., R. 1 E., W.M.

Bearing and distance from section or subdivision corner S. 41° E. 3155 ft. from NW Cor. of Sec. 7

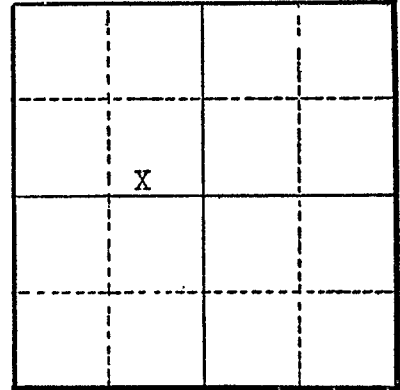

Section 7

Altitude at well 230 ft.

TYPE OF WELL: drilled Date Constructed 6/54

Depth drilled 259 ft. Depth cased 78 ft.

CASING RECORD: 6 inch from 0 to 78 ft.

FINISH:

AQUIFERS: 93½ - 259 ft. solid rock with breaks

WATER LEVEL: 52 ft.

PUMPING EQUIPMENT: Type Peerless turbine H.P. 10
Capacity 245 G.P.M. 1750 rpm

WELL TESTS:
Drawdown 16 ft. after _____ hours 245 G.P.M.
Drawdown _____ ft. after _____ hours _____ G.P.M.

USE OF WATER Irrigation Temp. _____ °F., 19

SOURCE OF INFORMATION _____

DRILLER or DIGGER John Beck

ADDITIONAL DATA:
Log X Water Level Measurements _____ Chemical Analysis _____ Aquifer Test _____

REMARKS:

