

STATE ENGINEER
Salem, Oregon

CLAC
009074
NOW EUGENE SCHUELLER

OBSERVATION WELL
Well Record

STATE WELL NO. 3/1-7H(1)
COUNTY Clackamas
APPLICATION NO. GR-1626

GR-1590 ~~1590~~

OWNER: Edwin E. Moser (FRANK HOYT)


MAILING ADDRESS: Rt. 1, Box 301

LOCATION OF WELL: Owner's No.

CITY AND STATE: Sherwood, Oregon

SE 1/4 NE 1/4 Sec. 7 T. 3 S., R. 1 W., W.M.

Bearing and distance from section or subdivision corner S. 14° W. 2290' from NE cor. Sec. 7

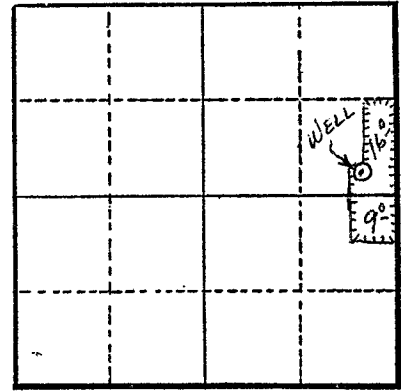

Section 7

Altitude at well

TYPE OF WELL: Drilled Date Constructed 1948

Depth drilled 275' Depth cased 26'

CASING RECORD:
8"

FINISH:

AQUIFERS:

WATER LEVEL:
65'

PUMPING EQUIPMENT: Type F. M. turbine H.P. 7 1/2
Capacity 100 G.P.M.

WELL TESTS:
Drawdown 200 ft. after 100 hours G.P.M.
Drawdown ft. after hours G.P.M.

USE OF WATER Irrigation Temp. °F., 19

SOURCE OF INFORMATION GR Record

DRILLER or DIGGER Simons & Gregory

ADDITIONAL DATA:
Log Water Level Measurements Chemical Analysis Aquifer Test

REMARKS:

- Log: Top soil 0 to 24 ft.
- Lava rock 24 to 94 ft.
- Basalt 94 to 159 ft.
- Gray basalt 159 to 244 ft.
- Porous lava 244 to 275 ft. (water bearing)

Irrigation of 25 acres.