


STATE ENGINEER  
Salem, Oregon

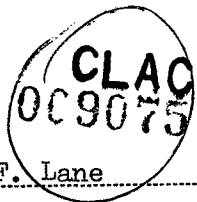


# Well Record

STATE WELL NO. 3/1-7N  
COUNTY Clackamas  
APPLICATION NO. GR-2510

OWNER: Harry F. Lane MAILING ADDRESS: Route 1, Box 364  
CITY AND STATE: Wilsonville, Oregon

LOCATION OF WELL: Owner's No. \_\_\_\_\_  
SW 1/4 SW 1/4 Sec. 7 T. 3 S., R. 1 W., W.M.

Bearing and distance from section or subdivision corner 450' E. 200' N.

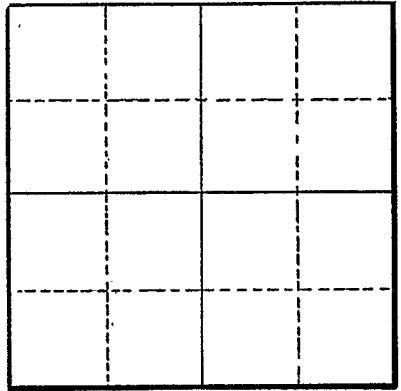

Section \_\_\_\_\_

Altitude at well \_\_\_\_\_

TYPE OF WELL: Drilled Date Constructed \_\_\_\_\_

Depth drilled 235 Depth cased 121

### CASING RECORD:

6 1/4-inch

### FINISH:

Perforations made 80 feet and 115 feet from ground level

### AQUIFERS:

Basalt (?)

### WATER LEVEL:

68 feet

PUMPING EQUIPMENT: Type Pomona deep well turbine H.P. 7 1/2  
Capacity 100 G.P.M.

### WELL TESTS:

Drawdown unknown ft. after \_\_\_\_\_ hours \_\_\_\_\_ G.P.M.  
Drawdown \_\_\_\_\_ ft. after \_\_\_\_\_ hours \_\_\_\_\_ G.P.M.

USE OF WATER Irrigation Temp. \_\_\_\_\_ °F. \_\_\_\_\_, 19\_\_\_\_\_

SOURCE OF INFORMATION GR-2377

DRILLER or DIGGER J. W. Beck, Canby, Oregon

### ADDITIONAL DATA:

Log  Water Level Measurements \_\_\_\_\_ Chemical Analysis \_\_\_\_\_ Aquifer Test \_\_\_\_\_

### REMARKS:

