

STATE ENGINEER
Salem, Oregon

CLAC
009107

Well Record

STATE WELL NO. 3/1-8L
COUNTY CLACKAMAS
APPLICATION NO. GR-3603

OWNER: Geo J. Hornung, Jr.

MAILING
ADDRESS:

Rt1 Box 307

LOCATION OF WELL: Owner's No.


CITY AND
STATE:

Wilsonville

NE 1/4 SW 1/4 Sec. 8 T. 3 S., R. 1 E., W.M.

Bearing and distance from section or subdivision

corner N 48° 15' E 3415' from SW cor. of Sec. 8

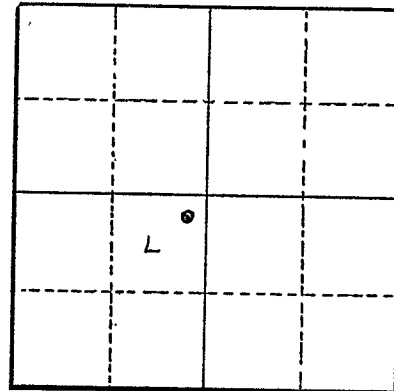

Section 8

Altitude at well

TYPE OF WELL: Drilled Date Constructed 1955

Depth drilled 495' Depth cased 40'

CASING RECORD:

6-inch

FINISH:

AQUIFERS:

WATER LEVEL:

120'

PUMPING EQUIPMENT: Type Sumo Submersible

Capacity 175 G.P.M.

H.P. 15

WELL TESTS:

Drawdown ft. after hours G.P.M.

Drawdown ft. after hours G.P.M.

USE OF WATER Irrigation

Temp. °F. 19

SOURCE OF INFORMATION GR-3975 ✓

DRILLER or DIGGER John Beck

ADDITIONAL DATA:

Log ^x Water Level Measurements Chemical Analysis Aquifer Test

REMARKS:

Ground 30'
Soapstone 30'
Basalt rock 435'