

STATE ENGINEER
Salem, Oregon

Well Record

STATE WELL NO. 3/1-9L
COUNTY CLACKAMAS
APPLICATION NO. GR-4038

OWNER: William Anderson

MAILING ADDRESS: Rt 1 Box 566

LOCATION OF WELL: Owner's No.

CITY AND STATE: West Linn, Oregon

NE $\frac{1}{4}$ SW $\frac{1}{4}$ Sec. 9 T. 3 S., R. 1 E., W.M.

Bearing and distance from section or subdivision

corner N 44°50' E, 2830' from SW cor of Sec 9


Altitude at well

TYPE OF WELL: Drilled Date Constructed 1953

Depth drilled 275' Depth cased 260'

CASING RECORD:

8-inch

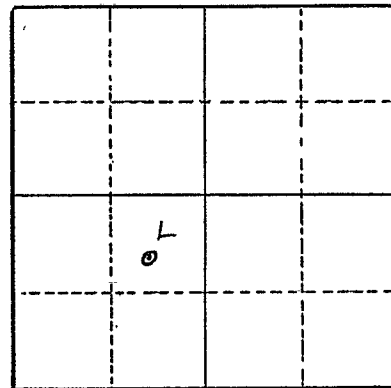

Section 9

FINISH:

AQUIFERS:

WATER LEVEL:

PUMPING EQUIPMENT: Type Turbine H.P. 10
Capacity 50 G.P.M.

WELL TESTS:

Drawdown 260 ft. after hours 50 G.P.M.

Drawdown ft. after hours G.P.M.

USE OF WATER Irrigation Temp. °F., 19.....

SOURCE OF INFORMATION GR-3914

DRILLER or DIGGER Simons & Gregory

ADDITIONAL DATA:

Log NA Water Level Measurements Chemical Analysis Aquifer Test

REMARKS: