

STATE ENGINEER
Salem, Oregon

CLACKAMAS Well Record
009387

STATE WELL NO. 3/1-18-B
COUNTY Clackamas
APPLICATION NO. GR-3380

OWNER: Wilbur Bruck


MAILING ADDRESS: Route 1 Box 316

LOCATION OF WELL: Owner's No.

CITY AND STATE: Wilsonville, Oregon

NW 1/4 NE 1/4 Sec. 18 T. 3 N. S. R. 1 E. W.M.

Bearing and distance from section or subdivision corner 2360' W and 1070' S.

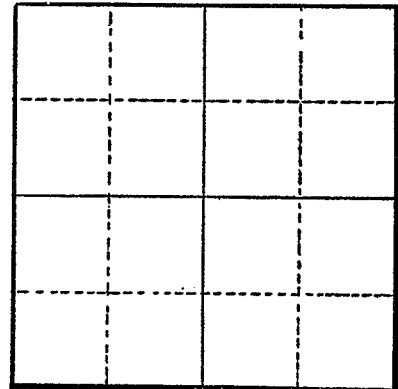

Section

Altitude at well

TYPE OF WELL: drilled Date Constructed 1950

Depth drilled 254' Depth cased 254'

CASING RECORD:

6"

FINISH:

5 slots per ft. of 3/8 x 1 1/2 2 rows from 185 to 200
from 223 to 235
from 250 to 254

AQUIFERS:

clay, topsoil, sand, basalt, gravel

WATER LEVEL:

78'

PUMPING EQUIPMENT: Type Peerless Turbine H.P. 10
Capacity 100 G.P.M.

WELL TESTS:

Drawdown 22 ft. after hours pumping 160 G.P.M.
Drawdown ft. after hours G.P.M.

USE OF WATER Irrigation Temp. °F. 19

SOURCE OF INFORMATION GR-3123

DRILLER or DIGGER

ADDITIONAL DATA:

Log Water Level Measurements Chemical Analysis Aquifer Test

REMARKS:

